IREDELL COUNTY HEALTH DEPARTMENT

4626-19-9237

STATESVILLE 704-878-5305 MOORESVILLE 704-664-[illegible]

IMPROVEMENT PERMIT / AUTHORIZATION TO CONSTRUCT / OPERATION PERMIT / EXISTING SYSTEM INSPECTION

PERMIT # 131297 PIN # 4626071828.490 DATE 12-10-08

OWNER or APPLICANT Greg Robbins PHONE: Business Greg 704 724 1511 Home:

OWNER or APPLICANT ADDRESS

LOCATION / DIRECTIONS Brawley School Rd TR McKendree TR Bare Feet Ln TR East Cold Hollow Farms

SUBDIVISION The Farms BLOCK / SECTION 4 LOT # 490 LOT AREA .766 Acre DESIGN FLOW 480 gpd L.T.A.R. .25 on left one

Septic Tank * 1000+ Gallons: STB 338 Date 9-18-08

Pump Tank ____ Gallons: P T ____ Date ____

Pump Make ____ Model ____ Serial # ____

Nitrification Field No Fields 1 No Lines 5 Linear Feet 500'

Trench Width 36" Max. Trench Bottom Depth 36" Gravel Depth N/A

☒ New System ☐ Repair ☐ Expansion System Type I (II) III IV V VI

System Description: Gravity - 25% Reduction

Repair System Description: Pump - LP - Panel Blk

Maintenance Agreement Required ☒ YES ☐ NO

☐ GRAVITY ☒ PRESSURE

☒ Residence No. Bedrooms 4 ☐ Business No. Persons ____ ☐ Other No. Employees ____


☐ Slab ☒ Crawl Space ☐ Basement w/plumbing ☐ Basement w/o plumbing

Water Supply: ☐ Private ☒ Public ☒ Community

Comments / Conditions: * Per Crescent developments specs Initial site evaluation by Same. ~~A~~ must stay 15ft from Storm drain with Septic System.

Comments / Conditions Note: Check Bonus room for "arched door" prior to issuing O.P. OK 1/16/09 MD 12/19/08 Checked tank & lines.

INITIAL SITE SKETCH

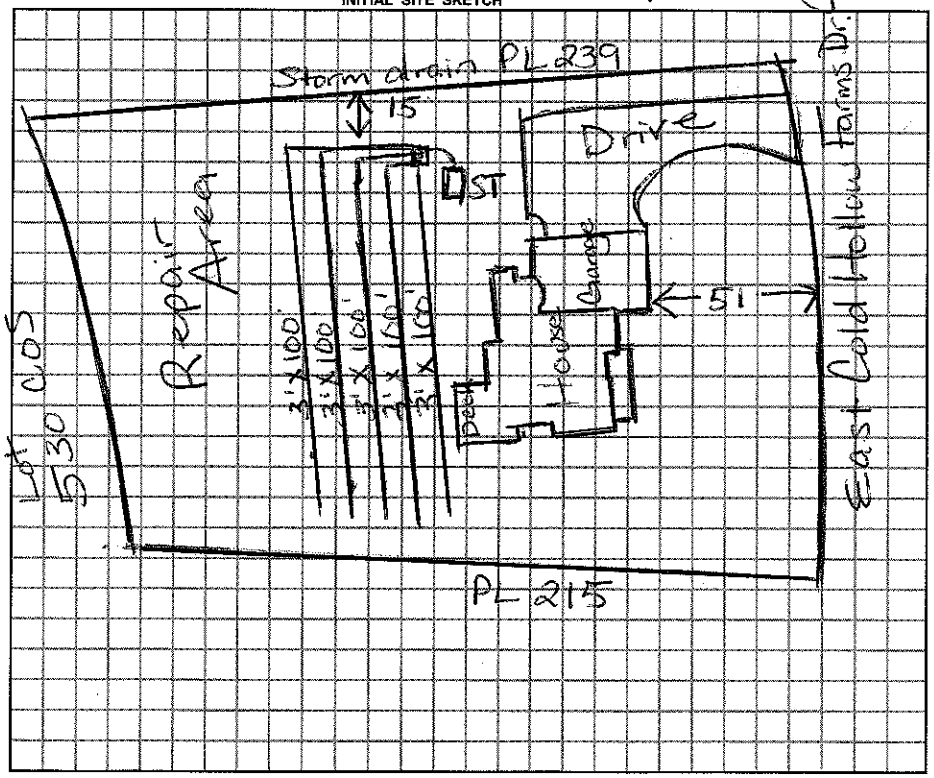

AS BUILT SKETCH

Installed EZ Flow drainlines As Drawn

Lakeview Shores Loop

Permit can be suspended or revoked if any false information is supplied toward securing the permit / any unauthorized changes are made to the site / any unauthorized changes are made in the installation of the system.

☐ IMPROVEMENT PERMIT w / site plan valid without expiration. ☐ IMPROVEMENT PERMIT w / site plan valid for 60 mos. ☐ AUTHORIZATION TO CONSTRUCT valid for period equal to IMPROVEMENT PERMIT-not to exceed 60 mo.

Owner / Applicant Signature: Greg Robbins Date 12-11-08

Improvement Permit by: Maria H. Dolan RS Date 12/10/08

Authorization to Construct by: Maria H. Dolan RS Date 12/10/08

YOU SHOULD CONTACT A LOCATOR SERVICE PRIOR TO ANY EXCAVATION.

Installed by: Kevin Hallman RS

Operation Permit by: Maria H. Dolan Date: 1/16/09

Existing System Inspected by: ____ Date: ____

WHITE COPY Environmental Health YELLOW COPY (Final) Owner / Applicant PINK COPY (Initial) Owner / Applicant