IREDELL COUNTY HEALTH DEPARTMENT

STATESVILLE 704-878-5305 MOORESVILLE 704-664-5281

IMPROVEMENT PERMIT / AUTHORIZATION TO CONSTRUCT / OPERATION PERMIT / EXISTING SYSTEM INSPECTION

PERMIT# 152287 PIN# 4626200907 DATE 9/15/08

OWNER OR APPLICANT Floyd Fowler PHONE: Business 704.564.7478 Home 704.364.2635

ADDRESS 4533 Arborway, Charlotte, NC 28211

LOCATION Brawley School Rd., TR Chuckwood, TL Barbershop, on left

SUBDIVISION CL&T BLOCK / SECTION 7 LOT 156 LOT AREA 0.58 SITE CLASS. P.S. DESIGN FLOW 480 sq/ft L.T.A.R. 0.35

Septic Tank: 1000 Gallons; STB ____ Date 2/12/98

Pump Tank: 1000 Gallons; PT ____ Date 2/12/98

Pump Make: Myers Model ME 40MC II Serial No. 2198

Nitrification Field: No Fields 1 Square Feet 1200' Linear Feet 300'

No Lines ~~1~~ 6 total, 3 new Trench Width 36" Max Trench Bottom Depth 36" Gravel Depth ____

☐ New System ☐ Repair ☑ Expansion System Type: I II ~~III~~ IV V VI

System Description: pump 25%

Repair System Description: LP PPBPS

Maintenance Agreement Required: ☐ Yes ☑ No

☑ House/Mod. Home No. Bedrooms 4

☐ Mobile Home No. Persons ____

☐ Business No. Employees ____


☐ Other ____

Water Supply: ☑ Individual ☐ Public ☐ Community

☐ Gravity ☑ Pressure ☐ Slab ☑ Crawl Space ☐ Basement w/plumbing ☐ Basement wo/plumbing

Comments:/Conditions:

INITIAL SITE SKETCH

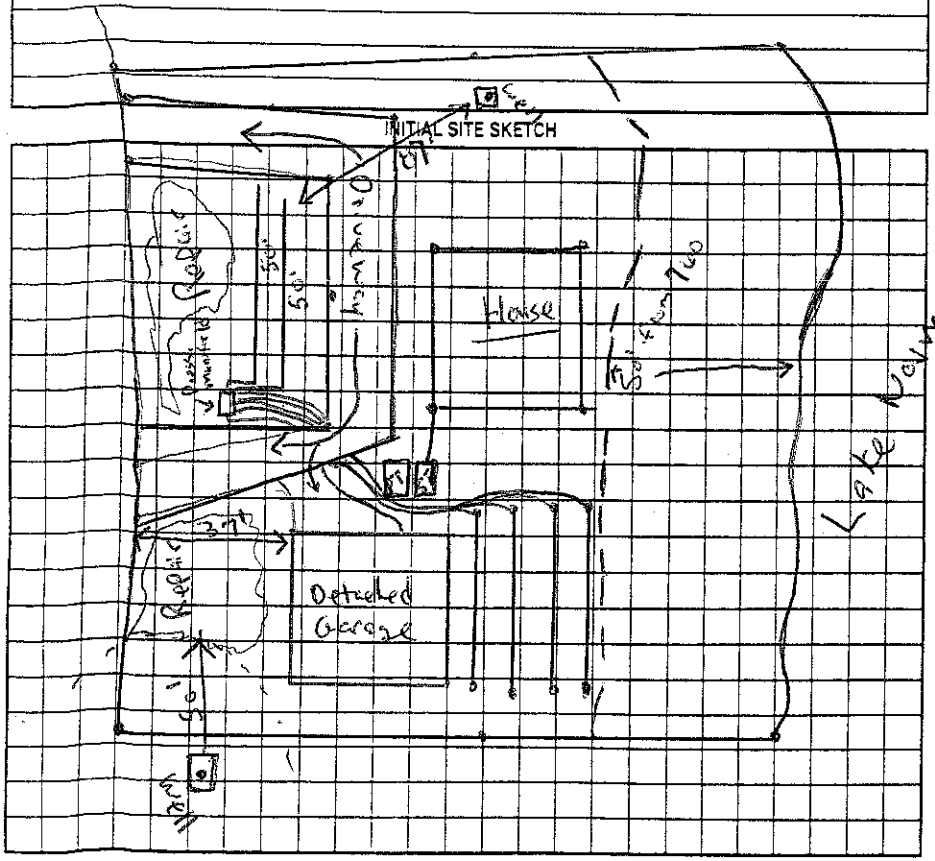

Comments:/Conditions: * Add 2@50' lines above driveway, & move Pressure manifold above the new lines.

* Case supply line underneath driveway

* Remove top 2 lines of existing system

AS BUILT SKETCH

* - Maintain all setbacks, Tanks & lines 5' from any building structure

* - Install on Contour

* Connect sewer line from Garage prior to entering tank (line coming from house)

* Septic must be moved before construction can begin.

Permit can be suspended or revoked if any false information is supplied toward securing the permit/any unauthorized changes are made to the site/any unauthorized changes are made in the installation of the system. Improvement Permit with plat valid without expiration ☐ Improvement Permit with site plan valid for sixty months ☑ Authorization to Construct is valid for a period equal to that of Improvement Permit – not to exceed sixty months.

Signed: [signature] date 9/17/08 Installed by: A Wastewater Solution Russell Williams

Improvement Permit by: [signature] date 9/15/08 Operation Permit by: [signature] date 9/25/08

Authorization to Construct by: [signature] date 9/15/08 Existing System Inspection by: ____ date ____

HEALTH DEPT. COPY: WHITE OWNER COPY (FINAL): YELLOW OWNER COPY (INITIAL): PINK