IREDELL COUNTY HEALTH DEPARTMENT

704-564-7478 313

~~STA~~ESVILLE 704-878-5305 MOORESVILLE 704-664-5281

IMPROVEMENT PERMIT / AUTHORIZATION TO CONSTRUCT / OPERATION PERMIT / EXISTING SYSTEM INSPECTION

PERMIT# 24848 PIN# 2E 1 A 156 DATE 4/3/98

OWNER OR CONTRACTOR Floyd Fowler PHONE: Business Home 364-2635

ADDRESS 4533 Arlington Charlotte NC. 28201

LOCATION Barber Loop - Dan Sch TR Chuckwood Rd TL 1st Barber Loop ~ 1/8 mile on (L) # 175

SUBDIVISION CL+T BLOCK / SECTION 7 LOT 156 LOT AREA .58 SITE CLASS. PS DESIGN FLOW 480 L.T.A.R. .35

Septic Tank: 1000 EXISTING Gallons; STB Date 2/12/98

Pump Tank: 1000 Gallons; PT 27 Date 2/12/98

Pump Make: MYERS Model ME 40 MC 11 Serial No. 2/98

Nitrification Field: No Fields 1 Square Feet 900 Linear Feet *300

No Lines 5 @ 60'x3' Trench Width 36" Max Trench Bottom Depth 36" Gravel Depth SAND.

☒ New System ☐ Repair System Type: I, II, (III) IV, V, VI

System Description: Pres. Man — Ch. Plastic

Repair System Description:

Maintenance Agreement Required: ☐ Yes ☒ No

☒ House/Mod. Home No. Bedrooms 4

☐ Mobile Home No. Bathrooms 3

☐ Business No. Employees

☐ Other


☐ Slab ☒ Crawl Space ☐ Basement w/plumbing ☐ Basement wo/plumbing

Water Supply: ☒ Individual ☐ Public ☐ Community

Comments:/Conditions: * 25% Reduction for Type III chamber

Comments:/Conditions:

INITIAL SITE SKETCH

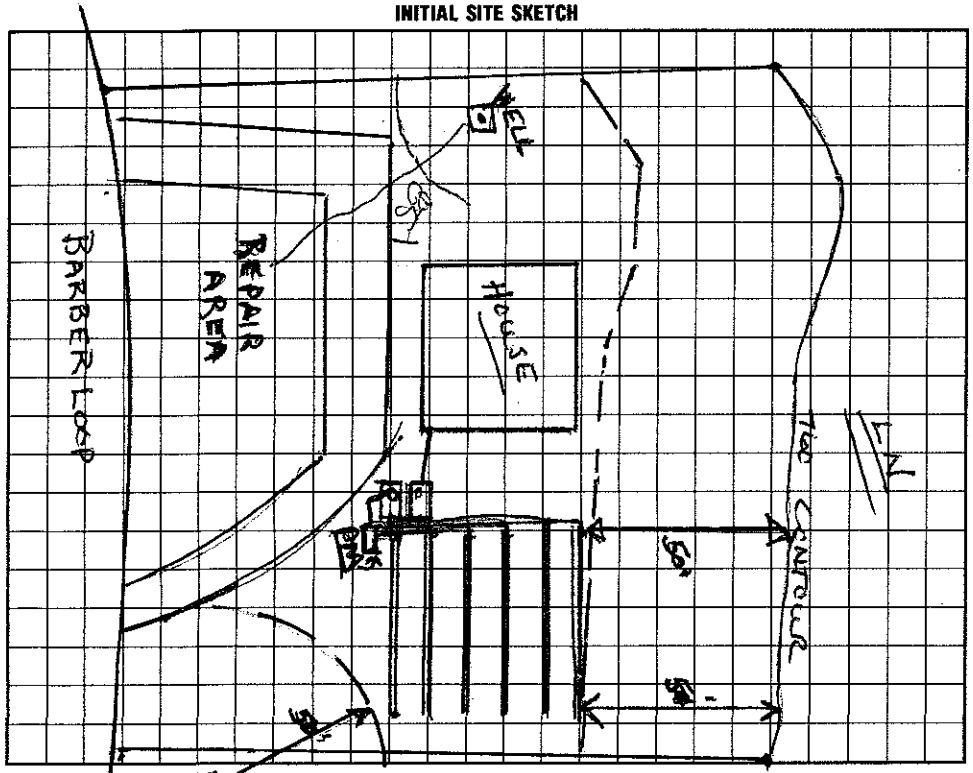

AS BUILT SKETCH

I understand that this permit can be suspended or revoked if any false information is supplied toward securing the permit/any unauthorized changes are made to the site/any unauthorized changes are made in the installation of the system. Improvement Permit with plat valid without expiration. Improvement Permit with site plan valid for sixty months. Authorization to Construct is valid for a period equal to that of Improvement Permit – not to exceed sixty months.

Signed: * Floyd M Fowler date 4/3/98

Improvement Permit by: Wesley Sparks RS. date 4/3/98

Authorization to Construct by: Wesley Sparks RS. date 4/3/98

Installed by: Floyd Fowler

Operation Permit by: Wesley Sparks RS date 5/1/98

Existing System Inspection by: Wesley Sparks RS date 5/1/98

HEALTH DEPT. COPY: WHITE INSPECTION COPY (FINAL): GREEN OWNER COPY (FINAL): YELLOW INSPECTION COPY (INITIAL): PINK OWNER COPY (INITIAL): GOLD