IREDELL COUNTY HEALTH DEPARTMENT

STATESVILLE 704-878-5305 50.00 Redraw MOORESVILLE 704-664-5281

IMPROVEMENT PERMIT / AUTHORIZATION TO CONSTRUCT / OPERATION PERMIT / EXISTING SYSTEM INSPECTION

PERMIT# 065637 PIN# 4625941684 4626-20-2327 DATE 11/6/2000

OWNER OR CONTRACTOR Crescent Resources / Daryl Pittman PHONE: Business 400-4709 Home

ADDRESS 400 S. Tryon St. Charlotte, NC 28201

LOCATION Brawley School Rd TR Bay Harbour Turn Shipyard Pt at end of Shipyard on right

SUBDIVISION Harbour BLOCK / SECTION VI LOT 24/24A LOT AREA SITE CLASS. PS DESIGN FLOW 480gpd L.T.A.R. .3

Septic Tank: 1000 Gallons; STB 794 Date 12-18-00

Pump Tank: 1000 Gallons; PT Date

Pump Make: Model Serial No.

Nitrification Field: No Fields 1 Square Feet 810' Linear Feet 270'

No Lines ~~3~~ 4 @ 90' Trench Width 36" Max Trench Bottom Depth 30"

☒ New System ☐ Repair System Type: I, II, III, IV, V, VI

System Description: OFFSITE 24A LP Panel Block *

Repair System Description: Same

Maintenance Agreement Required: ☒ Yes ☐ No

Gravel Depth N/A

☒ House/Mod. Home ☐ Mobile Home ☐ Business ☐ Other

No. Bedrooms 4 No. Bathrooms 4 No. Employees


☐ Slab ☐ Crawl Space ☐ Basement w/plumbing ☐ Basement wo/plumbing

Water Supply: ☐ Individual ☒ Public ☒ Community


Comments/Conditions: Keep tanks at least 50' from lake & 15' sidegradient of Basement (5' downgradient)

Comments/Conditions: * Drainfield located offsite on 24A 50% reduction in Drainfield area. Panel lines checked 12/8/2000 MD Polylok Filter

INITIAL SITE SKETCH

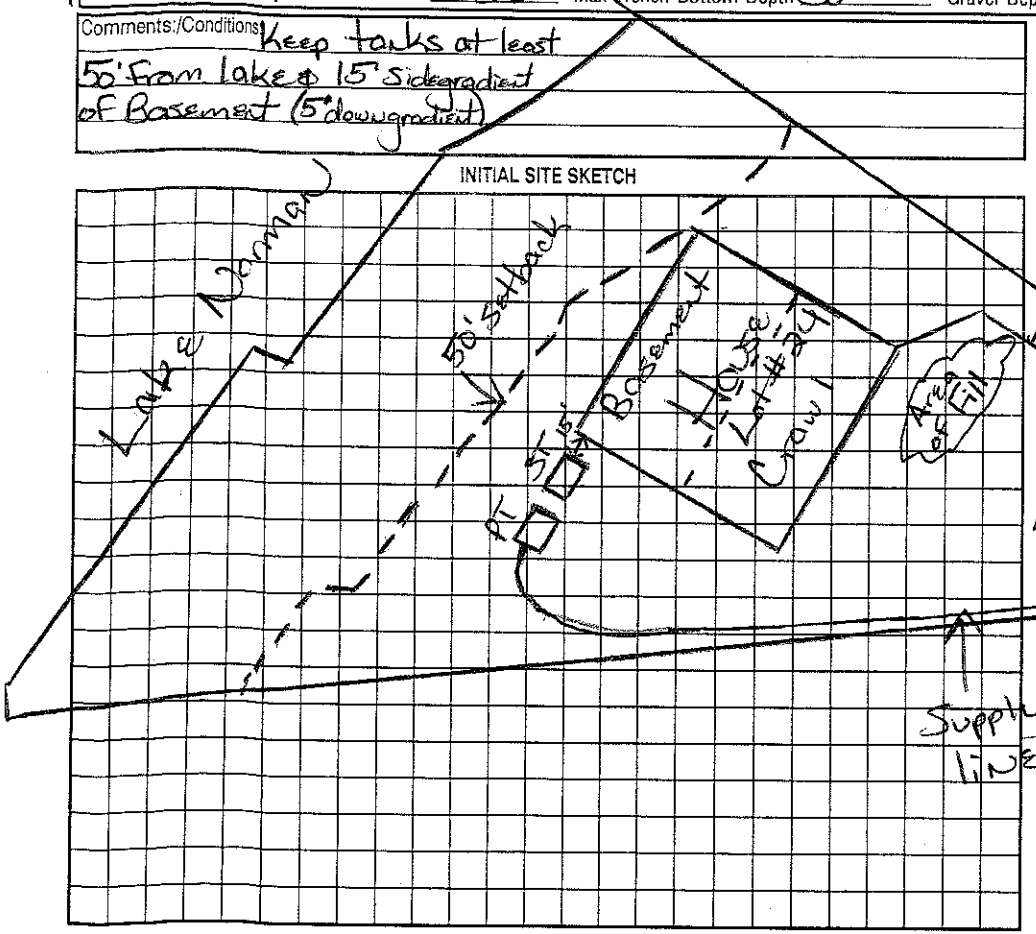

AS BUILT SKETCH

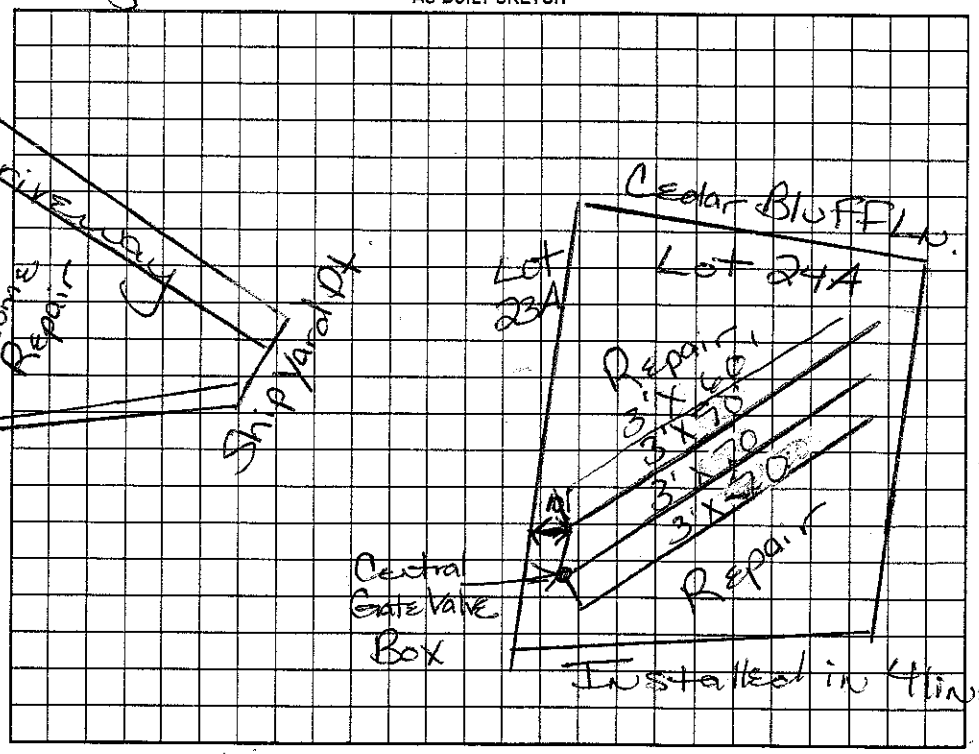

Permit can be suspended or revoked if any false information is supplied toward securing the permit/any unauthorized changes are made to the site/any unauthorized changes are made in the installation of the system. Improvement Permit with plat valid without expiration. Improvement Permit with site plan valid for sixty months. Authorization to Construct is valid for a period equal to that of Improvement Permit – not to exceed sixty months.

Signed: date

Improvement Permit by: Maria H. Dotson RS date 11/8/2000

Authorization to Construct by: Maria H. Dotson RS date 11/8/2000

Installed by: R&I

Operation Permit by: Maria H. Dotson RS date 4/18/2001

Existing System Inspection by: date

HEALTH DEPT. COPY: WHITE OWNER COPY (FINAL): YELLOW OWNER COPY (INITIAL): PINK