4626-20-3343

IREDELL COUNTY HEALTH DEPARTMENT

STATESVILLE 704-878-5305 MOORESVILLE 704-664-5281

IMPROVEMENT PERMIT / CERTIFICATE OF COMPLETION / OPERATION PERMIT / EXISTING SYSTEM INSPECTION

PROPERTY DESCRIPTION NO. 065634 DATE MAY 29, '97 TAX MAP NO. 4625944684 (pt.) 4626-20-3343 Watershed: ☑ Yes ☐ No

OWNER OR CONTRACTOR ~~Guarant Resources Inc.~~ TOM STEVENSON BLOCK CO. PHONE: Business _____ Home _____

ADDRESS PO Box 1003, Charlotte

LOCATION Brawley Sch Rd. TR Bay Harbour TR Shipyard Pt. Rd At end

SUBDIVISION The Harbour BLOCK / SECTION 6 LOT 23, 23A LOT AREA 25046 SITE CLASS. PS DESIGN FLOW 480gpd L.T.A.R. .03

Septic Tank: 1000 Gallons; STB 794 Date 12/5/98

Pump Tank: 1000 Gallons; PT 27 Date 12/3/98

Pump Make: _____ Model _____ Serial No. _____

Nitrification Field: No. Fields 1 Square Feet 540 Linear Feet 270

No Lines 6 6 Trench Width 24" Max Trench Bottom Depth 30" Gravel Depth NA

☑ New System ☐ Repair System Type: I, II, III, IV, V, VI

System Description: LP Panel Block

Repair System Description: Panel Block on 23A

Maintenance Agreement Required: ☐ Yes ☐ No

☑ House/Mod. Home No. Bedrooms 4

☐ Mobile Home No. Bathrooms 4

☐ Business No. Employees _____

☐ Other _____


☑ Slab ☐ Crawl Space ☑ Basement w/plumbing ☐ Basement wo/plumbing

Water Supply: ☐ Individual ☑ Community ☐ Public


Comments:

Comments: (PARTIAL) L2 Panels

INITIAL SITE SKETCH

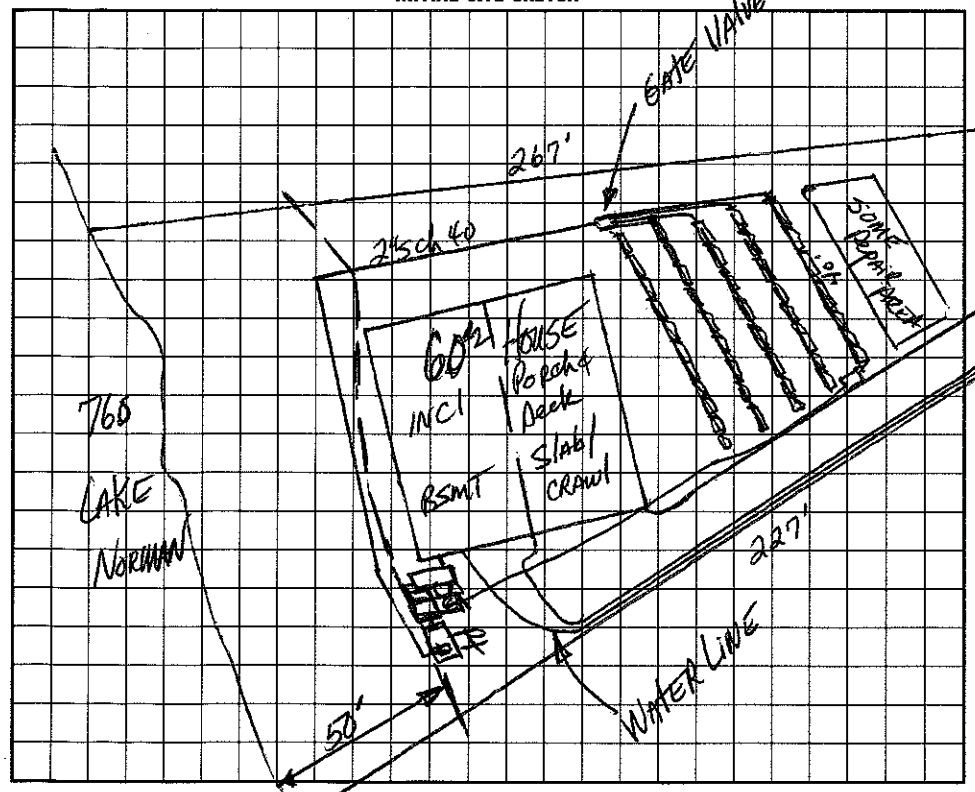

AS BUILT SKETCH

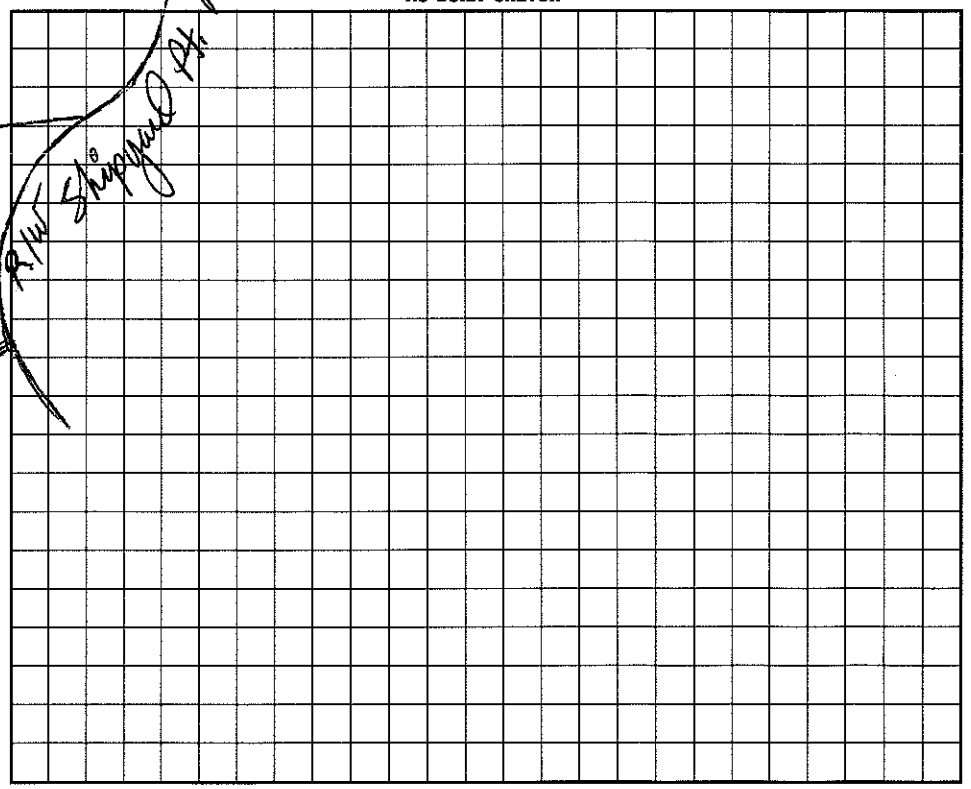

I understand that this permit can be suspended or revoked if any false information is supplied toward securing the permit/any unauthorized changes are made to the site/any unauthorized changes are made in the installation of the system. Improvement Permit is valid for 60 months from date of issuance.

Signed: _____

Improvement Permit by: _____ date 5-29-97

Existing System Inspection by: Wesley Sparks RS. date 7/7/98

Installed by: R + H elec.

Certificate of Completion by: Wesley Sparks RS. date 4/13/99

Operation Permit by: Wesley Sparks RS date 4/13/99

Authorization

HEALTH DEPT. COPY: WHITE INSPECTION COPY (FINAL): GREEN OWNER COPY (FINAL): YELLOW INSPECTION COPY (INITIAL): PINK OWNER COPY (INITIAL): GOLD