IREDELL COUNTY HEALTH DEPARTMENT

STATESVILLE 704-878-5305 MOORESVILLE 704-664-5281

IMPROVEMENT PERMIT / AUTHORIZATION TO CONSTRUCT / OPERATION PERMIT / EXISTING SYSTEM INSPECTION

PERMIT# 12415 PIN# 4626-20-3998 DATE 1/6/05

OWNER OR CONTRACTOR Rickey L. Sipe PHONE: Business (336) 945-3716 Home (336) 945-4383

ADDRESS 160 Ridge Gate Ct. Lewisville NC 27023

LOCATION BSR TR Chuckwood, TL 1st Barber LP 7th on LT

SUBDIVISION CLT BLOCK / SECTION 4 LOT 158 LOT AREA 0.73 AC SITE CLASS. PS DESIGN FLOW 480 L.T.A.R. 0.3

Septic Tank: 1000 Gallons; STB 1012 Date 2/1/06
Pump Tank: 1000 Gallons; PT 274 Date 2/6/06
Pump Make: Little Giant Model 9EH Serial No.
Nitrification Field: No Fields 1 Square Feet 1200 Linear Feet 460
No Lines 3 @ 133' Trench Width 36" Max Trench Bottom Depth 36" Gravel Depth —

☒ New System ☐ Repair System Type: I, II, III, IV, V, VI
System Description: Pump 25% Reduction
Repair System Description: Limited - Deeded Prior
Maintenance Agreement Required: ☐ Yes ☒ No To 1983


☒ House/Mod. Home No. Bedrooms 4
☐ Mobile Home No. Bathrooms
☐ Business No. Employees
☐ Other
☐ Slab ☒ Crawl Space ☐ Basement w/plumbing ☐ Basement wo/plumbing

Water Supply: ☒ Individual ☐ Public ☐ Community

Comments:/Conditions:

Existing Well Must be Abandoned

INITIAL SITE SKETCH 1" = 50'

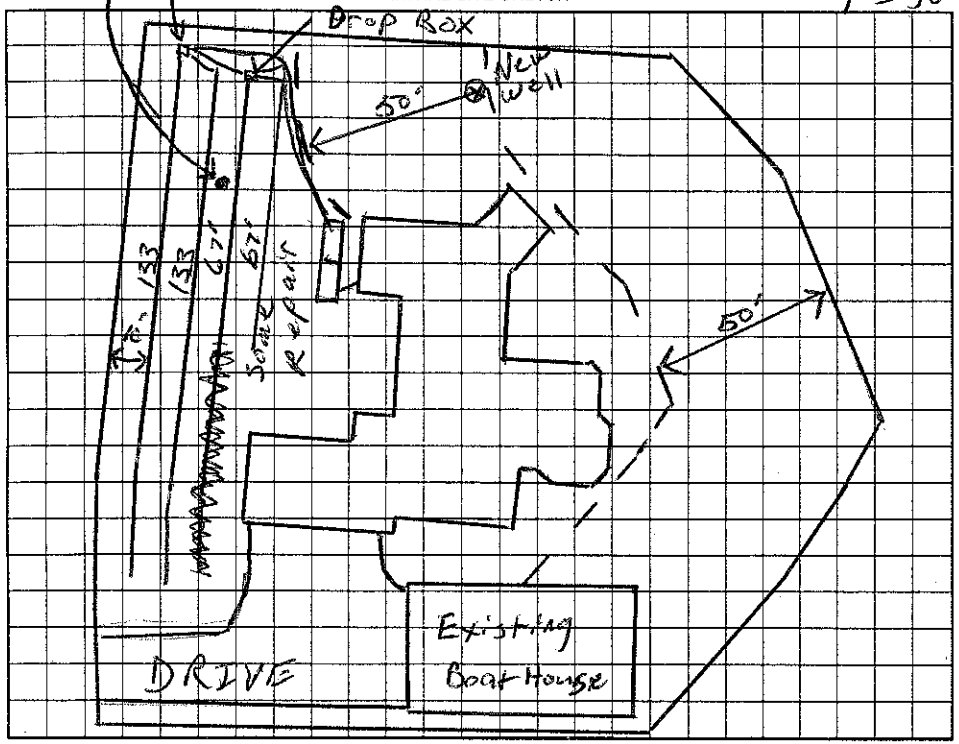

Comments:/Conditions:

AS BUILT SKETCH

Permit can be suspended or revoked if any false information is supplied toward securing the permit/any unauthorized changes are made to the site/any unauthorized changes are made in the installation of the system. Improvement Permit with plat valid without expiration. Improvement Permit with site plan valid for sixty months. Authorization to Construct is valid for a period equal to that of Improvement Permit – not to exceed sixty months.

Signed: Rickey L. Sipe date

Improvement Permit by: RS date 1/6/05

Authorization to Construct by: RS date 4/6/05

Installed by: Abernathy

Operation Permit by: RS date 4/17/06

Existing System Inspection by: date

HEALTH DEPT. COPY: WHITE OWNER COPY (FINAL): YELLOW OWNER COPY (INITIAL): PINK