IREDELL COUNTY HEALTH DEPARTMENT

STATESVILLE 704-878-5305 MOORESVILLE 704-664-5281

IMPROVEMENT PERMIT / AUTHORIZATION TO CONSTRUCT / OPERATION PERMIT / EXISTING SYSTEM INSPECTION

PERMIT# 065631 PIN# ~~4625441684~~ 4626-20-5235 DATE Dec 14 '98

OWNER OR CONTRACTOR Crescent Resources c/o Chris & Marcia Krug PHONE: Business _____ Home _____

ADDRESS PO Box 1003, Charlotte (Chris KRUG)

LOCATION Brawley Sch Rd. TR Bay Harbour TR Shipyard Pt. on Right

SUBDIVISION The Harbour BLOCK / SECTION 6 LOT 21 LOT AREA 30,698 ft² SITE CLASS. PS DESIGN FLOW 480gpd L.T.A.R. ~.3

Septic Tank: 1000 Gallons; STB 794 Date 1/16/99
Pump Tank: 1000 Gallons; PT _____ Date 5/28/99
Pump Make: MYERS Model ME-505-1 Serial No. 2199
Nitrification Field: No Fields 1 Square Feet 1200 Linear Feet 420
No Lines 4@100 Trench Width 36" Max Trench Bottom Depth ~30" Gravel Depth NA

☑ New System ☐ Repair System Type: I, II, III, ☑ V, VI
System Description: LP Panel Block
Repair System Description: Same
Maintenance Agreement Required: ☑ Yes ☐ No

☑ House/Mod. Home No. Bedrooms 4/4
☐ Mobile Home No. Bathrooms 4
☐ Business No. Employees _____
☐ Other _____
☑ Slab ☐ Crawl Space ☑ Basement w/plumbing ☐ Basement wo/plumbing


Water Supply: ☐ Individual ☑ Public ☑ Community

Comments:/Conditions: This permit replaces permit issued 5-29-97.


Comments:/Conditions: (PARTIAL) LS - 11,860 - 8.49 Drawdown

1"=40'

INITIAL SITE SKETCH

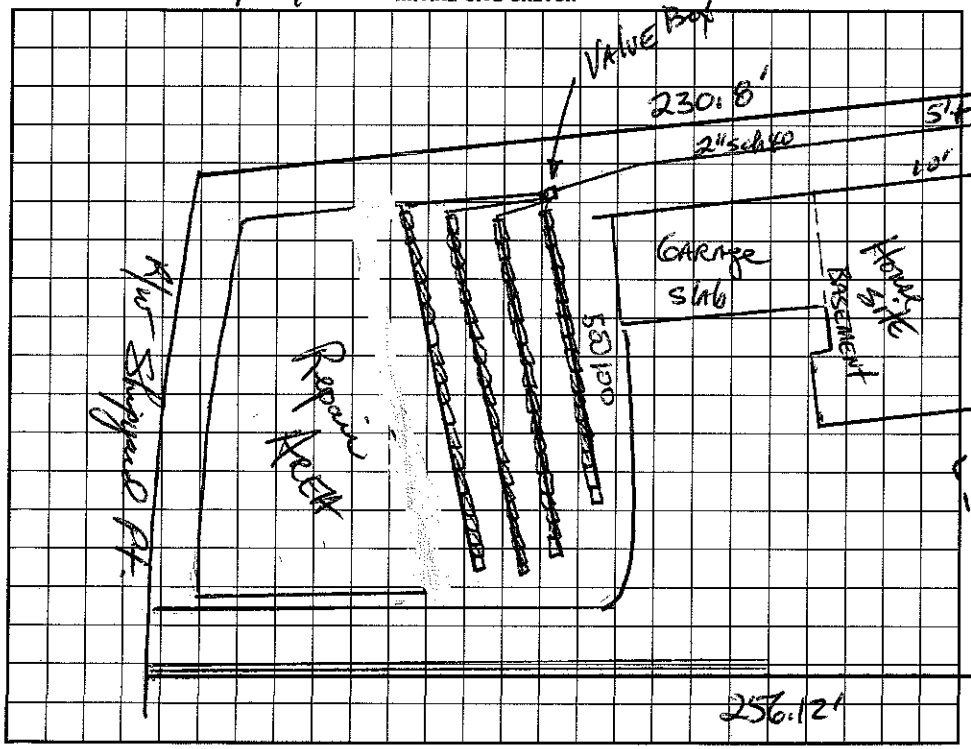

AS BUILT SKETCH

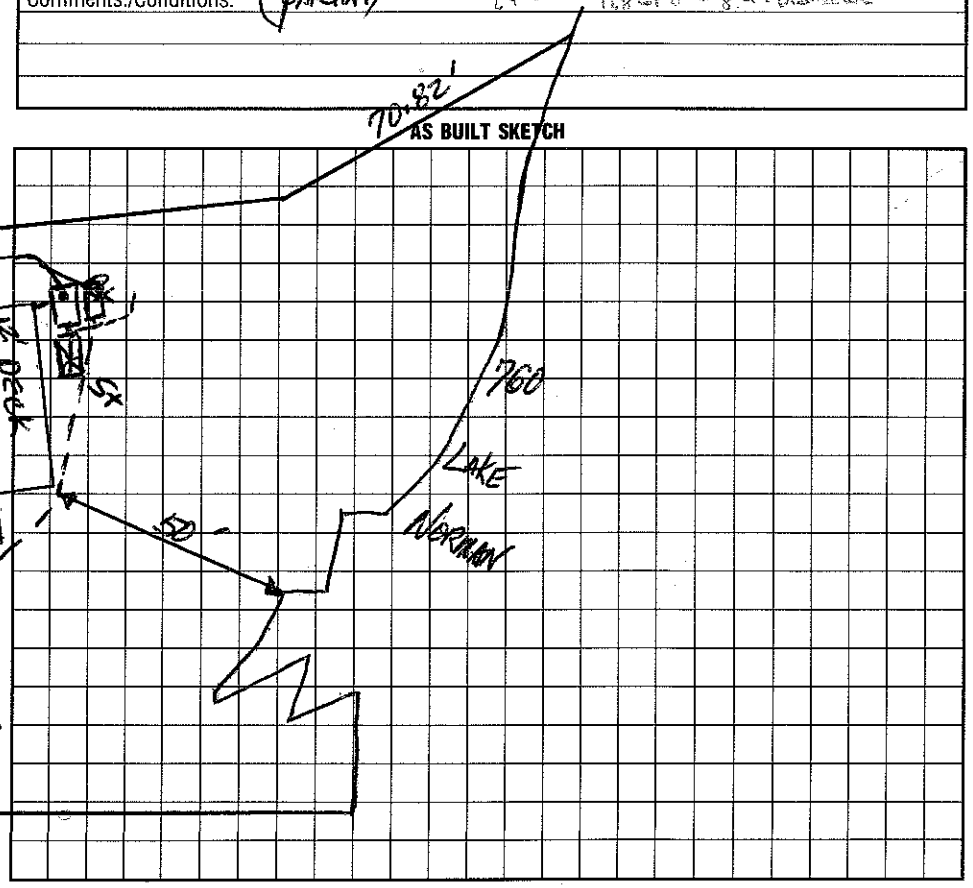

I understand that this permit can be suspended or revoked if any false information is supplied toward securing the permit/any unauthorized changes are made to the site/any unauthorized changes are made in the installation of the system. Improvement Permit with plat valid without expiration. Improvement Permit with site plan valid for sixty months. Authorization to Construct is valid for a period equal to that of Improvement Permit – not to exceed sixty months.

Signed: Frances Kelly date 12-14-98

Improvement Permit by: _____ RS date 12-14-98

Authorization to Construct by: _____ RS date 12-14-98

Installed by: Chris Hedrick / Brad Russell

Operation Permit by: _____ RS date 7/23/99

Existing System Inspection by: _____ date _____

HEALTH DEPT. COPY: WHITE INSPECTION COPY (FINAL): GREEN OWNER COPY (FINAL): YELLOW INSPECTION COPY (INITIAL): PINK OWNER COPY (INITIAL): GOLD