IREDELL COUNTY HEALTH DEPARTMENT

Const. Auth. STATESVILLE 704-878-5305 MOORESVILLE 704-664-528[illegible]

IMPROVEMENT PERMIT / ~~CERTIFICATE OF COMPLETION~~ / OPERATION PERMIT / EXISTING SYSTEM INSPECTION

PROPERTY DESCRIPTION NO. 065625 DATE May 29, '97 TAX MAP NO. 4625941684 (pt.) 4626-20-6189 Watershed: ☑ Yes ☐ No

OWNER OR CONTRACTOR Crescent Resources Inc. // Jim Ballard PHONE: Business _____ Home _____

ADDRESS PO Box 1003, Charlotte

LOCATION Brawley Sch Rd; TR Bay Harbour TR Shipyard Pt TR Beech Pt. Ln. on left corner lot

SUBDIVISION The Harbour BLOCK / SECTION 6 LOT 20 LOT AREA >30,000 ft² SITE CLASS. PS DESIGN FLOW 480 gpd L.T.A.R. .3

Septic Tank: 1000 Gallons; STB 1012 Date 9-19-2000

Pump Tank: 1000 Gallons; PT 17 Date 10-1-2000

Pump Make: Myers Model ME50 Serial No. _____

Nitrification Field: No. Fields 1 Square Feet 540 Linear Feet ~~270~~ 275

No Lines 4 Trench Width 24" Max Trench Bottom Depth 30" Gravel Depth NA

☑ New System ☐ Repair System Type: I, II, III, IV, V, VI

System Description: LP Panel Block

Repair System Description: LP Panel Block

Maintenance Agreement Required: ☑ Yes ☐ No

☑ House/Mod. Home No. Bedrooms 4

☐ Mobile Home No. Bathrooms 4

☐ Business No. Employees _____

☐ Other _____


☐ Slab ☐ Crawl Space ☑ Basement w/plumbing ☐ Basement wo/plumbing

Water Supply: ☐ Individual ☑ Community ☐ Public

Comments: POOR House Site, House site will Require modification to provide positive stormwater diversion. Keep heavy equipment off septic system AREA. Drainfield must go exactly where shown. BEECH POINTE LANE

Comments: 6-7-2000 - Reviewed house plan; appears in compliance w/ I.P. 5/32 hole. Checked tanks & lines 1/11/2001

INITIAL SITE SKETCH

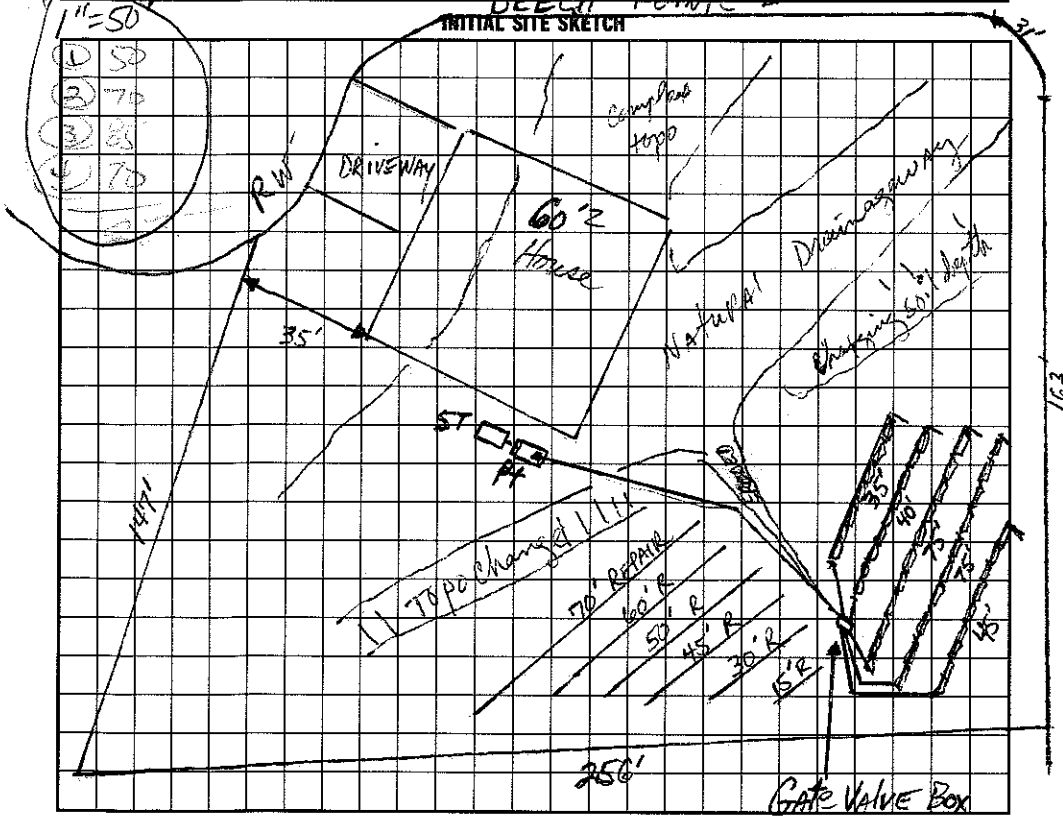

AS BUILT SKETCH

Installed 4 Panel lines.

I understand that this ~~permit~~ can be suspended or revoked if any false information is supplied toward securing the permit/any unauthorized changes are made to the site/any unauthorized changes are made in the installation of the system. Improvement Permit is valid for ~~60~~ months from date of issuance.

Signed: *[signature]

Improvement Permit by: DR Hamm RS date 5-29-97

~~Existing System Inspection~~ CONSTRUCTION AUTHORIZATION by: Wesley R Hamm RS date 6-7-00

Installed by: Richard Abernathy

Certificate of Completion by: _____ date _____

Operation Permit by: Wesley Sparks RS. date 2/26/01

HEALTH DEPT. COPY: WHITE INSPECTION COPY (FINAL): GREEN OWNER COPY (FINAL): YELLOW INSPECTION COPY (INITIAL): PINK OWNER COPY (INITIAL): GOLD