IREDELL COUNTY HEALTH DEPARTMENT

STATESVILLE 704-878-5305 MOORESVILLE 704-664-5281

IMPROVEMENT PERMIT / AUTHORIZATION TO CONSTRUCT / OPERATION PERMIT / EXISTING SYSTEM INSPECTION

PERMIT# 065623 PIN# 4625941684 pt 4626206491 DATE 6/8/98

OWNER OR CONTRACTOR KENNETH BEALER HOME PHONE: Business 662-6400 Home

ADDRESS

LOCATION BRAWLEY SCHOOL - TR BAY HARBOUR - TR SHIPYARD PT - TR BEECH PT LN AT END

SUBDIVISION HARBOUR BLOCK / SECTION 6 LOT 19 LOT AREA 38015 SF SITE CLASS PS DESIGN FLOW 450 GPD L.T.A.R. .36 GPD/FT

Septic Tank: 1000 Gallons; STB 794 Date 5/28/98

Pump Tank: 1000 Gallons; PT 29 Date 6/29/98

Pump Make: HYDROMATIC Model SK50A1 Serial No. 6/98

Nitrification Field: No Fields 1 Square Feet 1200 Linear Feet 400

No Lines 5 @ 80' Trench Width 36" Max Trench Bottom Depth 36" Gravel Depth

☐ New System ☐ Repair System Type: I, II, (III), IV, V, VI

System Description: PUMP 25% REDUCTION

Repair System Description: PANEL

Maintenance Agreement Required: ☐ Yes ☑ No

☑ House/Mod. Home No. Bedrooms 4

☐ Mobile Home No. Bathrooms 4

☐ Business No. Employees

☐ Other

☐ Slab ☑ Crawl Space ☐ Basement w/plumbing ☐ Basement wo/plumbing


Water Supply: ☐ Individual ☐ Public ☑ Community

Comments:/Conditions:


Comments:/Conditions:

1" = 40'

INITIAL SITE SKETCH

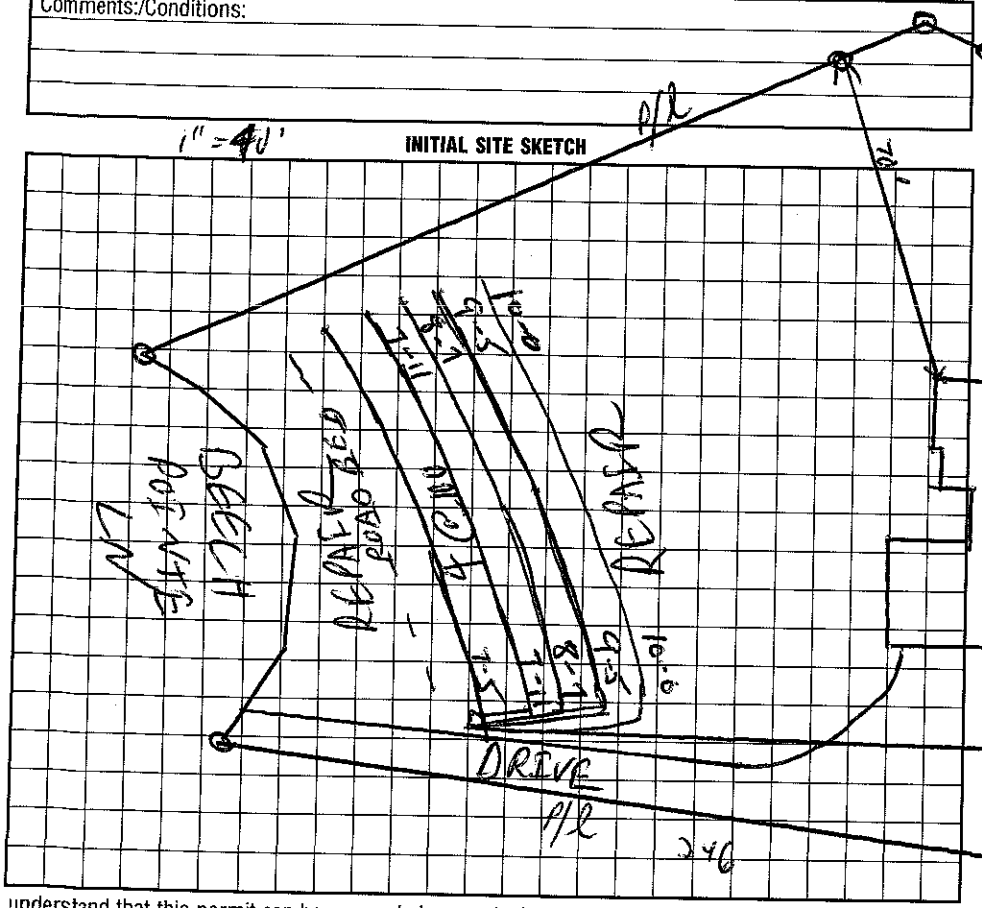

AS BUILT SKETCH

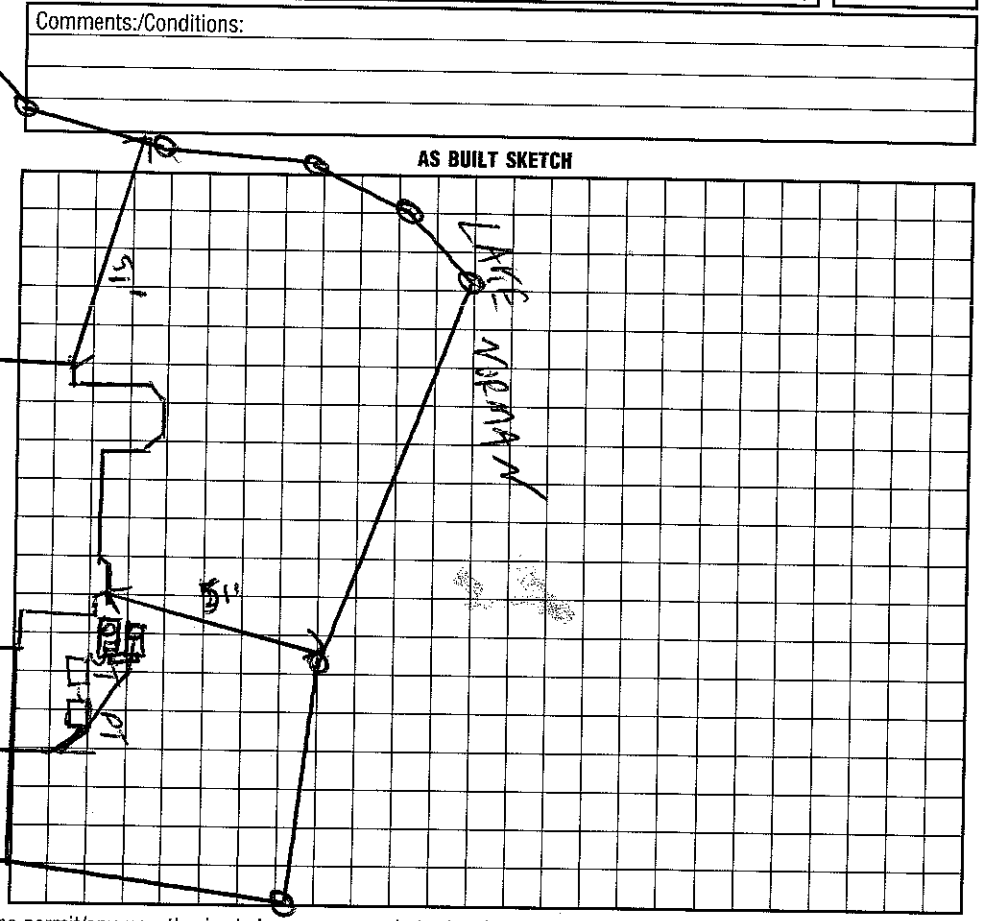

I understand that this permit can be suspended or revoked if any false information is supplied toward securing the permit/any unauthorized changes are made to the site/any unauthorized changes are made in the installation of the system. Improvement Permit with plat valid without expiration. Improvement Permit with site plan valid for sixty months. Authorization to Construct is valid for a period equal to that of Improvement Permit – not to exceed sixty months.

Signed: Dana Wright date 6/8/98 Installed by: Tim Simmons

Improvement Permit by: C. Zimmerman date 6/8/98 Operation Permit by: Wesley Sparks R.S. date 2/18/99

Authorization to Construct by: C. Zimmerman date 6/8/98 Existing System Inspection by: date

HEALTH DEPT. COPY: WHITE INSPECTION COPY (FINAL): GREEN OWNER COPY (FINAL): YELLOW INSPECTION COPY (INITIAL): PINK OWNER COPY (INITIAL): GOLD