IREDELL COUNTY HEALTH DEPARTMENT

STATESVILLE 704-878-5305 MOORESVILLE 704-664-5281

IMPROVEMENT PERMIT / AUTHORIZATION TO CONSTRUCT / OPERATION PERMIT / EXISTING SYSTEM INSPEC

PERMIT# 065696 PIN# 4625941684(pt) 4626 20 8173 DATE 2/25/

OWNER OR CONTRACTOR CRESCENT RESOURCES INC. PHONE: Business _____ Home _____

ADDRESS PO BOX 1003 CHARLOTTE

LOCATION BRAWLEY SCHOOL RD - TR BAY HARBOUR - TR SAILYARD PT - BEECH PT LN

SUBDIVISION HARBOUR BLOCK / SECTION 6 LOT 15 LOT AREA > 20,000sf > SITE CLASS. PS DESIGN FLOW 480GPD L.T.A.R. .3000/SF

Septic Tank: 1000 Gallons; STB 317 Date 8/9/99

Pump Tank: 1000 Gallons; PT 27 Date 9/7/99

Pump Make: GOULDS Model WE03111M Serial No. K9932714

Nitrification Field: No Fields 1 Square Feet 1200 Linear Feet 400

No Lines 4@100' Trench Width 36" Max Trench Bottom Depth 36" Gravel Depth N/A

☑ New System ☐ Repair System Type: I, II, (III) IV, V, VI

System Description: PUMP CHAMBERS OR HDS

Repair System Description: PUMP PANEL

Maintenance Agreement Required: ☐ Yes ☑ No

☑ House/Mod. Home No. Bedrooms 4

☐ Mobile Home No. Bathrooms 4

☐ Business No. Employees ____

☐ Other ____


☐ Slab ☑ Crawl Space ☐ Basement w/plumbing ☐ Basement wo/plumbing

Water Supply: ☐ Individual ☐ Public ☑ ~~Community~~

Comments:/Conditions:

Comments:/Conditions:

1"=50' INITIAL SITE SKETCH

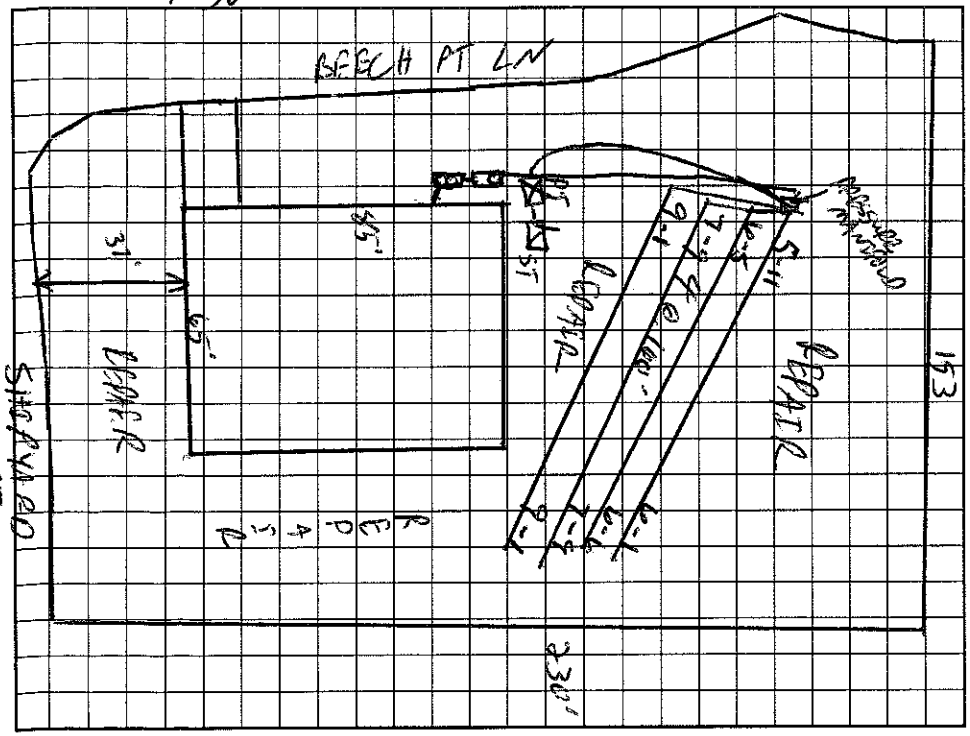

AS BUILT SKETCH

Permit can be suspended or revoked if any false information is supplied toward securing the permit/any unauthorized changes are made to the site/any unauthorized changes are made in the installation of the system. Improvement Permit with plat valid without expiration. Improvement Permit with site plan valid for sixty months. Authorization to Construct is valid for a period equal to that of Improvement Permit – not to exceed sixty months.

Signed: _____ date 3/2/99 Installed by: F J ERVIN

Improvement Permit by: _____ RS date 2/25/99 Operation Permit by: _____ RS date 11/7/99

Authorization to Construct by: _____ RS date 2/25/99 Existing System Inspection by: _____ date _____

HEALTH DEPT. COPY: WHITE OWNER COPY (FINAL): YELLOW OWNER COPY (INITIAL): PINK