IREDELL COUNTY HEALTH DEPARTMENT Const. Auth. STATESVILLE 704-878-5305 MOORESVILLE 704-664-5281

IMPROVEMENT PERMIT / ~~CERTIFICATE OF COMPLETION~~ / OPERATION PERMIT / EXISTING SYSTEM INSPECTION

PROPERTY DESCRIPTION NO. 065619 DATE May 28, '97 TAX MAP NO. 4625944684 (pt.) 4626 208426 Watershed: ☑ Yes ☐ No

OWNER OR CONTRACTOR Crescent Resources Clne. (MECKLENBURG HOMES) PHONE: Business _____ Home _____

ADDRESS PO Box 1003, Charlotte

LOCATION Brawley Sch Rd. TR Bay Harbour TR Shipyard Pt. TR Beech Pt. Ln. at end

SUBDIVISION The Harbour BLOCK / SECTION 6 LOT 18 LOT AREA 28118 ft² SITE CLASS. RS DESIGN FLOW 480 gpd L.T.A.R. .83

Septic Tank: 1000 Gallons; STB 794 Date 3/15/94

Pump Tank: 1000 Gallons; PT 27 Date 11/15/94

Pump Make: _____ Model _____ Serial No. _____

Nitrification Field: No. Fields 1 Square Feet 1200 Linear Feet 400

No Lines 5@80' Trench Width 36" Max Trench Bottom Depth 36" Gravel Depth NA

☑ New System ☐ Repair System Type: I, II, (III), IV, V, VI

System Description: pm chambered

Repair System Description: LP Panel Block

Maintenance Agreement Required: ☐ Yes ☑ No

☐ House/Mod. Home No. Bedrooms 4

☐ Mobile Home No. Bathrooms 4

☐ Business No. Employees _____

☐ Other _____


☑ Slab ☐ Crawl Space ☑ Basement w/plumbing ☐ Basement wo/plumbing

Water Supply: ☐ Individual ☑ Community ☐ Public


Comments: * ONE INSPECTION/OBSERVATION PORT PER LATERAL

Comments: (PARTIAL)

INITIAL SITE SKETCH 1" = 50'

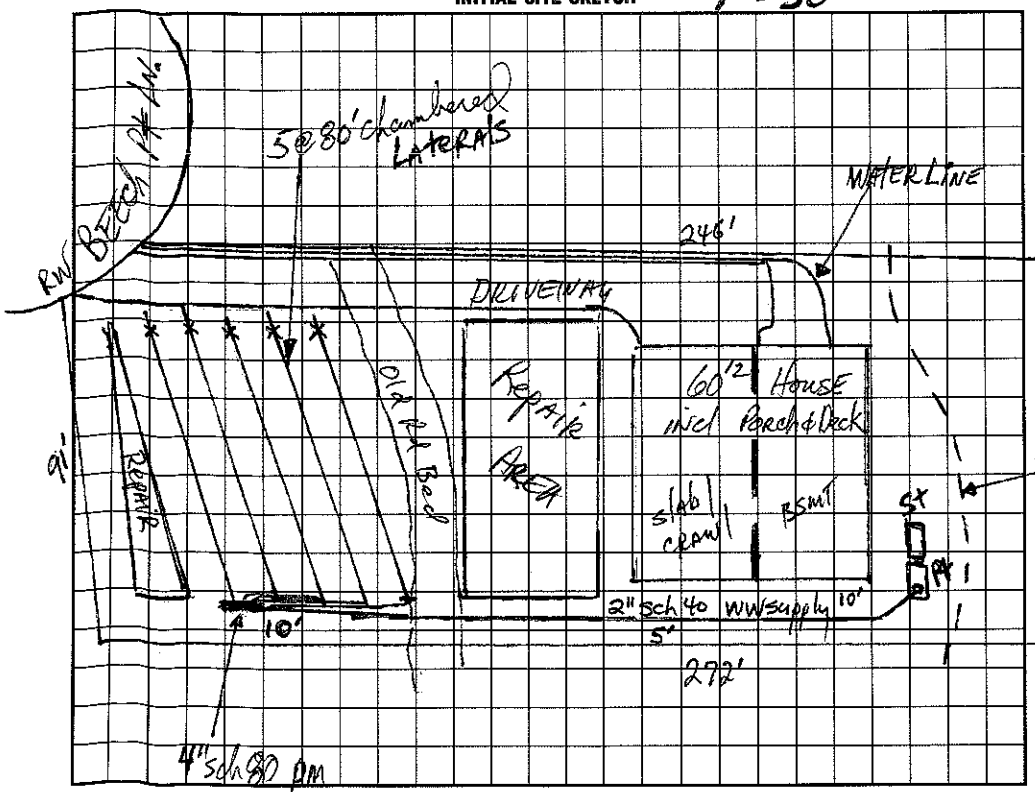

AS BUILT SKETCH

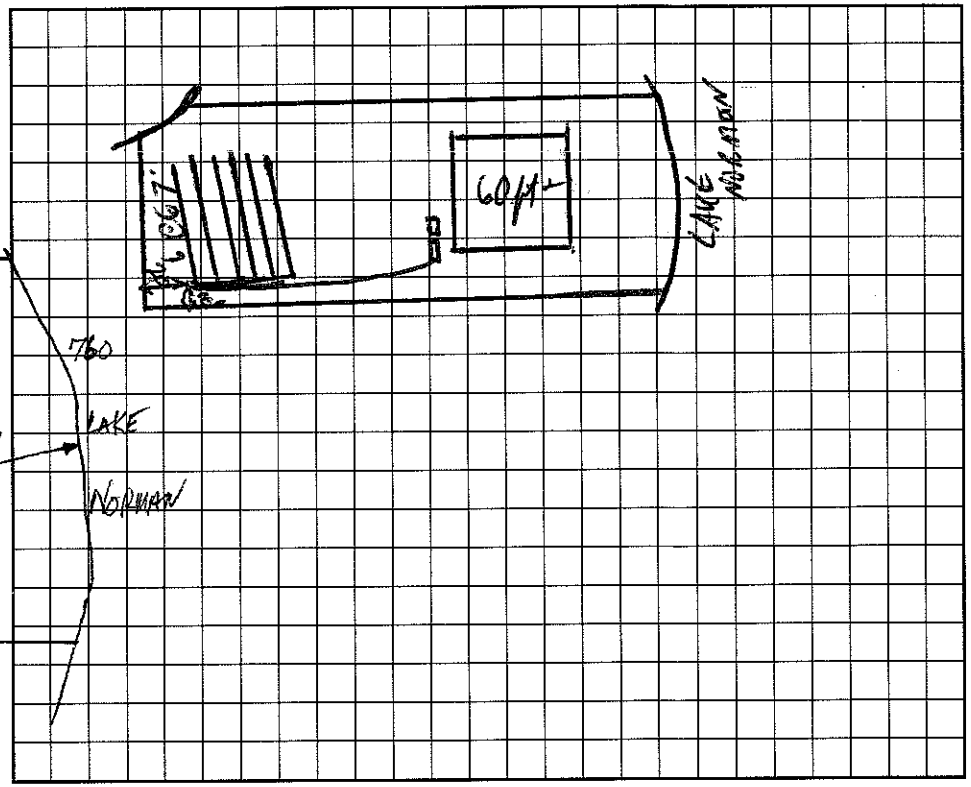

I understand that ~~this~~ permit can be suspended or revoked if any false information is supplied toward securing the permit/any unauthorized changes are made to the site/any unauthorized changes are made in the installation of the system. Improvement Permit is valid for 60 months from date of issuance.

Signed: _____

Improvement Permit by: _____ RS date 5-28-97

~~Construction~~ ~~Existing System Inspection~~ Authorization by: _____ RS date 8/20/98

Installed by: ORBISON

Certificate of Completion by: _____ date _____

Operation Permit by: Wesley Sparks RS. date 3/17/99

HEALTH DEPT. COPY: WHITE INSPECTION COPY (FINAL): GREEN OWNER COPY (FINAL): YELLOW INSPECTION COPY (INITIAL): PINK OWNER COPY (INITIAL): GOLD