IREDELL COUNTY HEALTH DEPARTMENT

Construct Auth

STATESVILLE 704-878-5305 MOORESVILLE 704-664-5281

IMPROVEMENT PERMIT / CERTIFICATE OF COMPLETION / OPERATION PERMIT / EXISTING SYSTEM INSPECTION

PROPERTY DESCRIPTION NO. 065682 DATE 11/20/97 TAX MAP NO. 4625941684 pt Watershed: ☒ Yes ☐ No

OWNER OR CONTRACTOR South-Dickenson Homes PHONE: Business 46226 20 9078 Home

ADDRESS P.O. Box 2428 Cornelius, NC 28031

LOCATION Brawley School Rd. TR Bay Harbour TR Shipyard Pt. on right 2nd lot past Cade's Cove

SUBDIVISION The Harbour BLOCK / SECTION 6 LOT 14 LOT AREA 720,000 ft² SITE CLASS. PS DESIGN FLOW 300 gpd L.T.A.R. ÷ 3

Septic Tank: 1000 Gallons; STB 794 Date

Pump Tank: 1000 Gallons; PT Date

Pump Make: Model Serial No.

Nitrification Field: No Fields 1 Square Feet ± 900' Linear Feet ± 300'

No Lines 4 at 75' Trench Width 36" Max Trench Bottom Depth 36" Gravel Depth N/A

☒ New System ☐ Repair System Type: I, II, ☒ III, IV, V, VI

System Description: Pump (Pm) Plastic Chambers

Repair System Description: Pump to Modified Similar

Maintenance Agreement Required: ☐ Yes ☐ No

☒ House/Mod. Home ☐ Mobile Home ☐ Business ☐ Other

No. Bedrooms 3 No. Bathrooms No. Employees


☐ Slab ☐ Crawl Space ☐ Basement w/plumbing ☐ Basement wo/plumbing

Water Supply: ☐ Individual ☒ Community ☐ Public

Comments: ± 25% reduction System

Comments:

INITIAL SITE SKETCH Scale 1:50'

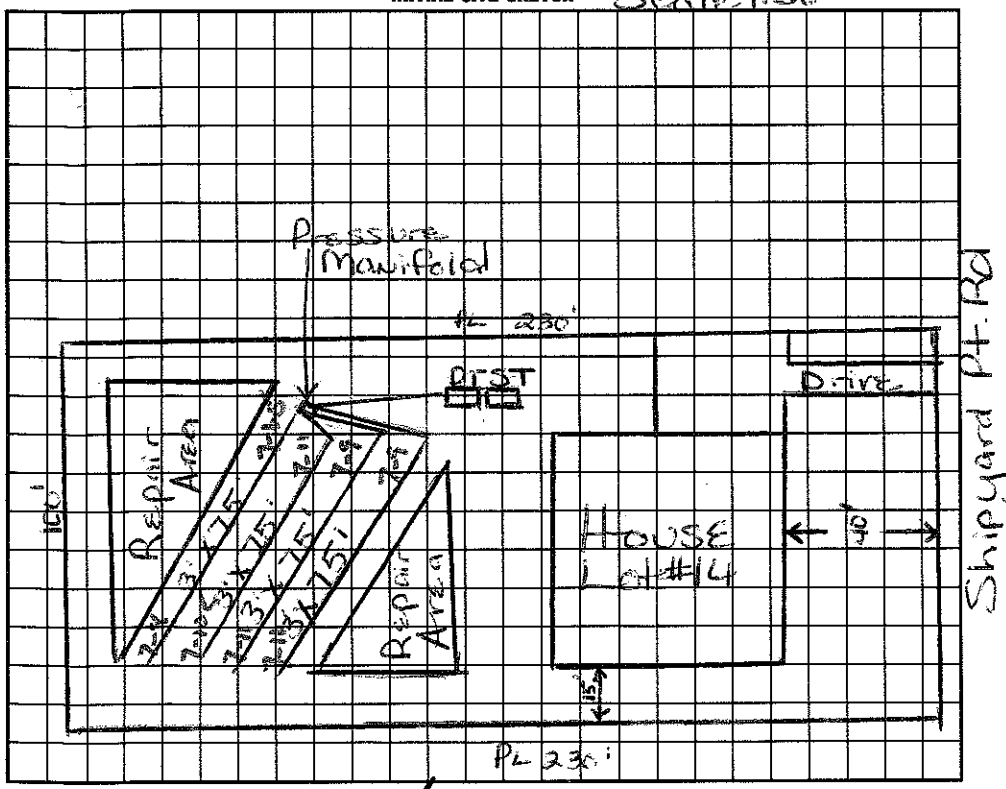

AS BUILT SKETCH

I understand that this permit can be suspended or revoked if any false information is supplied toward securing the permit/any unauthorized changes are made to the site/any unauthorized changes are made in the installation of the system. Improvement Permit is valid for 60 months from date of issuance.

Signed: Roger Awtrey

Improvement Permit by: Maria H. Watson date 11/20/97

Existing System Inspection by: Maria H. Watson date 11/20/97

Installed by: David Clark

Certificate of Completion by: date

Operation Permit by: Wesley Sparks RES. date 8/19/98

HEALTH DEPT. COPY: WHITE INSPECTION COPY (FINAL): GREEN OWNER COPY (FINAL): YELLOW INSPECTION COPY (INITIAL): PINK OWNER COPY (INITIAL): GOLD

Construct Auth.