IREDELL COUNTY HEALTH DEPARTMENT

4626 209299 2:30

STATESVILLE 704-878-5305 MOORESVILLE 704-664-5281

IMPROVEMENT PERMIT / CERTIFICATE OF COMPLETION / OPERATION PERMIT / EXISTING SYSTEM INSPECTI

PROPERTY DESCRIPTION NO. 065617 DATE May 27, 97 TAX MAP NO. 4625 4684 (pt.) Watershed: ☑ Yes ☐ No

OWNER OR CONTRACTOR Crescent Resources Inc. / William Lowell PHONE: Business Home

ADDRESS PO Box 1033, Charlotte

LOCATION Brawley Sch Rd. TR Bay Harbour TR Shipyard Pt. Ln. TR Beech Pt. Ln. on Right

SUBDIVISION The Harbour BLOCK / SECTION 6 LOT 16 LOT AREA 7 20,000 ft² SITE CLASS 15 DESIGN FLOW 480 gpd L.T.A.R. .3

Septic Tank: 1000 Gallons; STB 744 Date 5/27/97

Pump Tank: 1000 Gallons; PT 27 Date 5/29/97

Pump Make: Model Serial No.

Nitrification Field: No Fields 1 Square Feet 560 Linear Feet 280

No Lines 4 Trench Width 24" Max Trench Bottom Depth 30 Gravel Depth N/A

☑ New System ☐ Repair System Type: I, II, III, IV, V, VI

System Description: LP Panel Block

Repair System Description: LP Panel Block

Maintenance Agreement Required: ☑ Yes ☐ No

☑ House/Mod. Home No. Bedrooms 4

☐ Mobile Home No. Bathrooms 4

☐ Business No. Employees

☐ Other

☐ Slab ☑ Crawl Space ☐ Basement w/plumbing ☐ Basement wo/plumbing


Water Supply: ☐ Individual ☑ Community ☐ Public

Comments: 10-30-98 Plant removed - appears in compliance w/ I.P. JK

Comments:

Scale 1"=50'

INITIAL SITE SKETCH

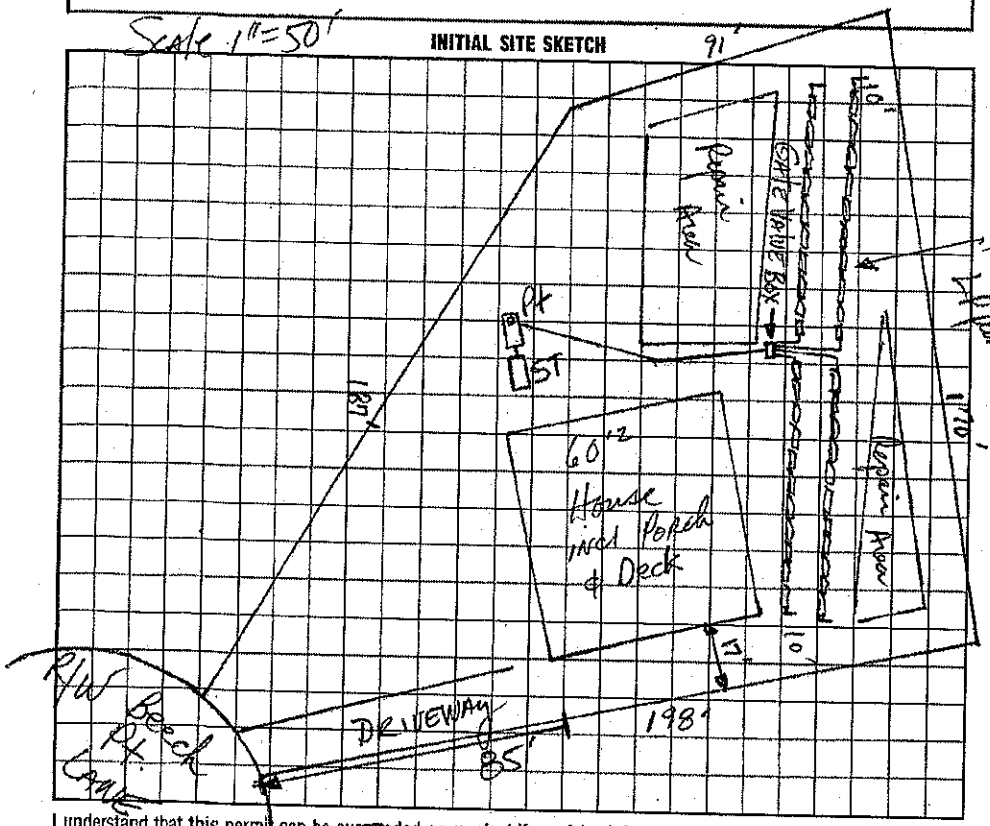

AS BUILT SKETCH

I understand that this permit can be suspended or revoked if any false information is supplied toward securing the permit/any unauthorized changes are made to the site/any unauthorized changes are made in the installation of the system. Improvement Permit is valid for 60 months from date of issuance.

Signed: X

Improvement Permit by: [signature] RS date 5-27-97

Construction Authorization / ~~Existing System Inspection by~~: Mark R. Hinson RS date 10-30-98

Installed by: Wayne Ordison

Certificate of Completion by: [signature] RS date 7/1/99

Operation Permit by: [signature] RS. date 7/1/99

HEALTH DEPT. COPY: WHITE INSPECTION COPY (FINAL): GREEN OWNER COPY (FINAL): YELLOW INSPECTION COPY (INITIAL): PINK OWNER COPY (INITIAL): GOLD