# IREDELL COUNTY HEALTH DEPARTMENT

STATESVILLE 704-878-5305 MOORESVILLE 704-664-5281

## IMPROVEMENT PERMIT / AUTHORIZATION TO CONSTRUCT / OPERATION PERMIT / EXISTING SYSTEM INSPECTION

PERMIT # 15070 PIN # ~~4626-71-0421~~ 4626210344 DATE 10-5-12

OWNER or APPLICANT LAKE LUXURY HOMES PHONE: Business 704-516-2344 Home:

OWNER or APPLICANT ADDRESS PO Box 3798 MOORESVILLE

LOCATION / DIRECTIONS BSR, TR CHUCKWOOD, ON L

SUBDIVISION WATERTREE LANDING BLOCK / SECTION LOT # 96 LOT AREA 1.11AC DESIGN FLOW 600 L.T.A.R. .3

Septic Tank #1500 Gallons: STB 338 Date 11-21-12

Pump Tank Gallons: P T Date

Pump Make Model Serial #

Nitrification Field No Fields 1 No Lines 6 Linear Feet 500'

Trench Width 36" Max. Trench Bottom Depth 36" Gravel Depth —

☒ New System ☐ Repair ☐ Expansion System Type I II III IV V VI

System Description: 25% REDUCTION

Repair System Description: PANEL

Maintenance Agreement Required ☐ YES ☒ NO

☒ GRAVITY ☐ PRESSURE

☒ Residence No. Bedrooms 5

☐ Business No. Persons

☐ Other No. Employees

☐ Slab ☐ Crawl Space


☒ Basement w/plumbing ☐ Basement w/o plumbing

Water Supply: ☒ Private ☐ Public ☐ Community


Comments / Conditions: POOL MUST BE 15' FROM SEPTIC

Comments / Conditions

INITIAL SITE SKETCH

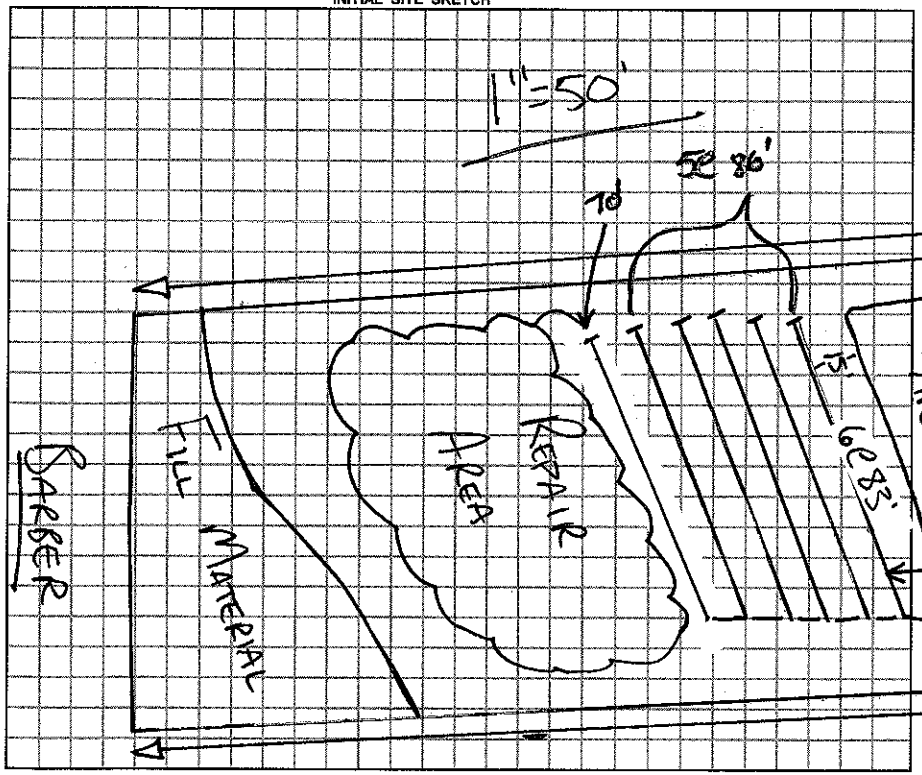


AS BUILT SKETCH

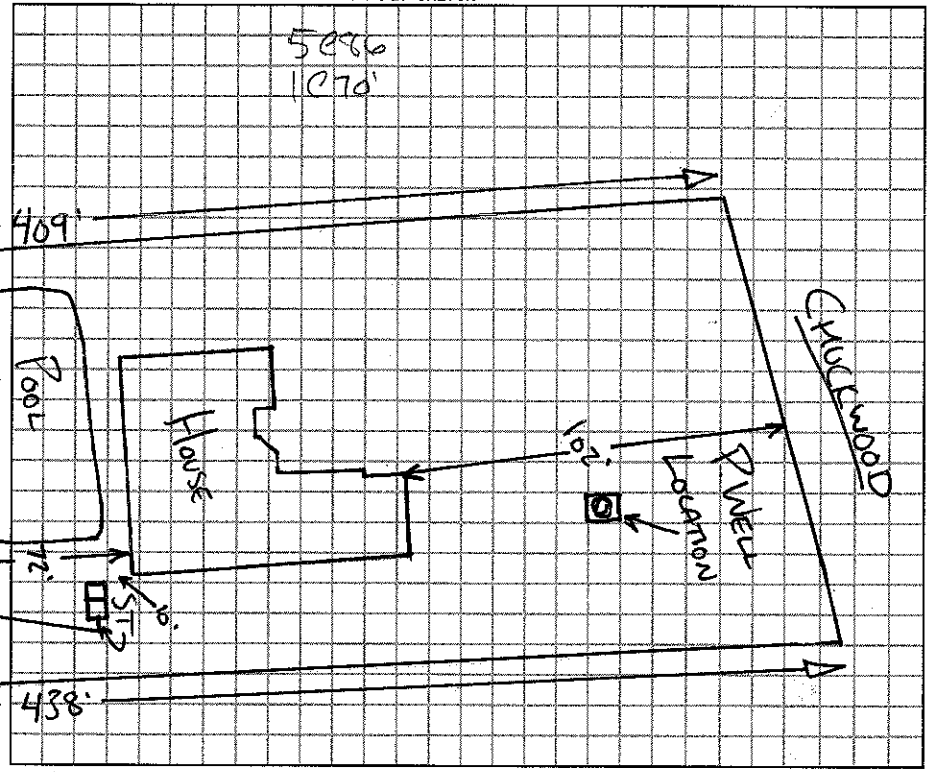


*Permit can be suspended or revoked if any false information is supplied toward securing the permit / any unauthorized changes are made to the site / any unauthorized changes are made in the installation of the system.*

☐ *IMPROVEMENT PERMIT w / plat valid without expiration.* ☒ *IMPROVEMENT PERMIT w / site plan valid for 60 mos.* ☒ *AUTHORIZATION TO CONSTRUCT valid for period equal to IMPROVEMENT PERMIT-not to exceed 60 mo.*

Owner / Applicant Signature: Date 10/9/12

Improvement Permit by: REHS Date 10-5-12

Authorization to Construct by: REHS Date 10-5-12

***YOU SHOULD CONTACT A LOCATOR SERVICE PRIOR TO ANY EXCAVATION.***

Installed by: WASTEWATER SOLUTIONS

Operation Permit by: Date: 1-16-13

Existing System Inspected by: Date:

WHITE COPY Environmental Health YELLOW COPY (Final) Owner / Applicant PINK COPY (Initial) Owner / Applicant