IREDELL COUNTY HEALTH DEPARTMENT

STATESVILLE 704-878-5305 50.00 Paid MOORESVILLE 704-664-5281

IMPROVEMENT PERMIT / AUTHORIZATION TO CONSTRUCT / OPERATION PERMIT / EXISTING SYSTEM INSPECTION

PERMIT# 119334 PIN# 4626 21 2748.005 4626210720

OWNER OR CONTRACTOR Hans Baker DATE 4/1/05

ADDRESS 154 Peninsula Dr. Mooresville, NC 28117 PHONE: Business 704-201-4992 Home

LOCATION 1100 TR Chuckwood Rd. lot on R before Indian Trail

SUBDIVISION Waterview Landing / SECTION LOT 5 LOT AREA 30,000 SITE CLASS. PS DESIGN FLOW 480 L.T.A.R. .3

Septic Tank: 2@1000 Gallons; STB 794/794 Date 10/14/04 10/14/04 ☒ New System ☐ Repair System Type: I, II, III, IV, V, VI

Pump Tank: Gallons; PT Date System Description: GRAVITY - 25% Reduced

Pump Make: Model Serial No. Repair System Description: Same

Nitrification Field: No Fields 1 Square Feet 1200 Linear Feet 400 Maintenance Agreement Required: ☐ Yes ☒ No

No Lines 4@100' Trench Width 3' Max Trench Bottom Depth 3' Gravel Depth NA

☒ House/Mod. Home No. Bedrooms 4
☐ Mobile Home No. Bathrooms 4
☐ Business No. Employees
☒ Other Standard Pump - Bsmt


☐ Slab ☐ Crawl Space ☒ Basement w/plumbing ☐ Basement wo/plumbing

Water Supply: ☒ Individual ☐ Public ☐ Community


Comments:/Conditions:

Comments:/Conditions: EZ FLOW INSTALLED

INITIAL SITE SKETCH (1" = 50')

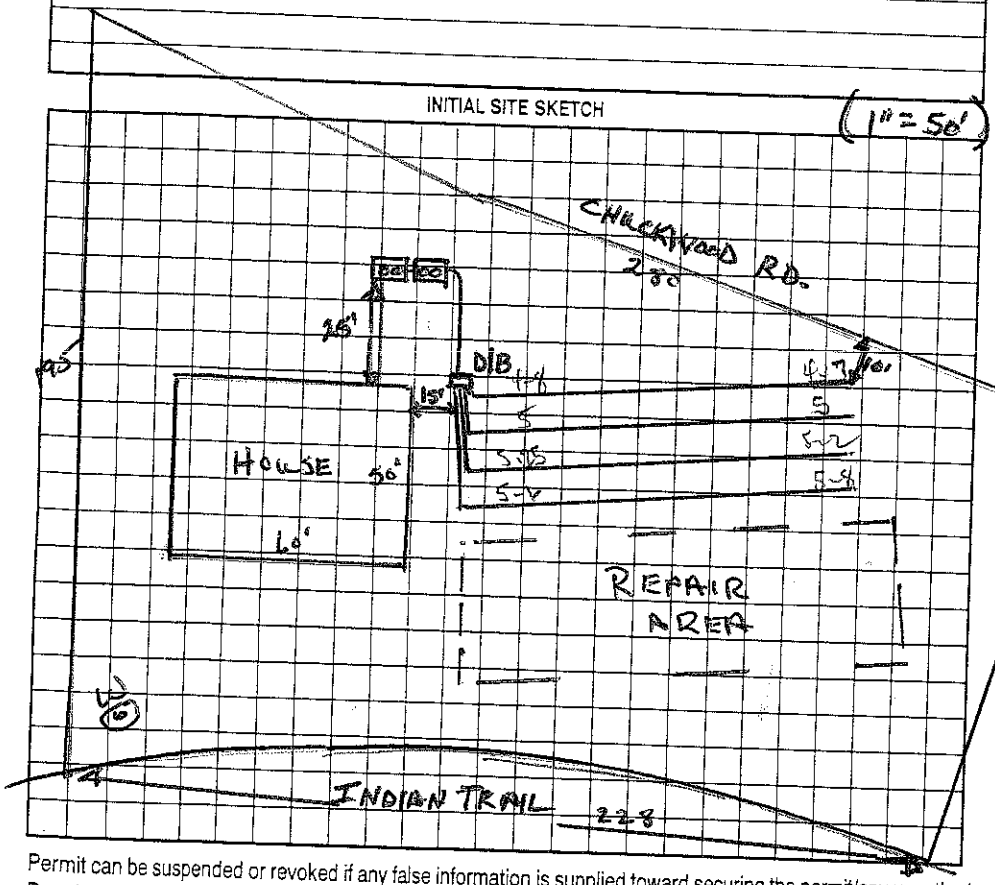

AS BUILT SKETCH

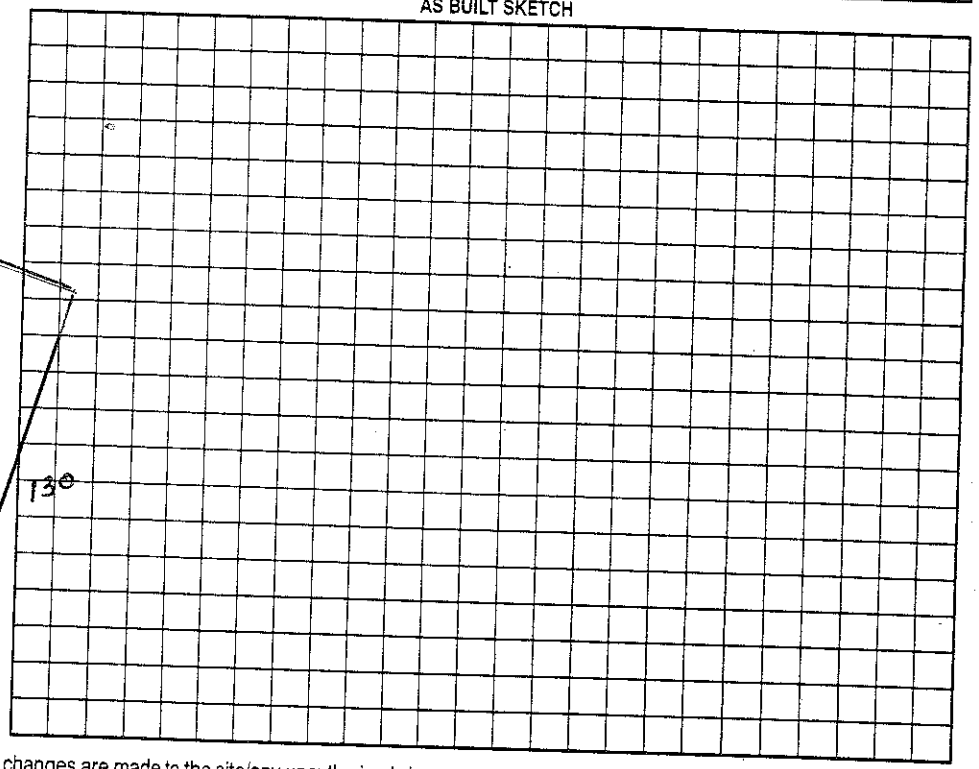

Permit can be suspended or revoked if any false information is supplied toward securing the permit/any unauthorized changes are made to the site/any unauthorized changes are made in the installation of the system. Improvement Permit with plat valid without expiration. Improvement Permit with site plan valid for sixty months. Authorization to Construct is valid for a period equal to that of Improvement Permit – not to exceed sixty months.

Signed: Hans Baker date 4-5-05 Installed by: Howard Backhoe

Improvement Permit by: Wesley Sparks RS. date 4/1/05 Operation Permit by: Wesley Sparks RS date 4/6/05

Authorization to Construct by: Wesley Sparks RS date 4/1/05 Existing System Inspection by: date

HEALTH DEPT. COPY: WHITE OWNER COPY (FINAL): YELLOW OWNER COPY (INITIAL): PINK