# IREDELL COUNTY HEALTH DEPARTMENT
## IMPROVEMENT PERMIT / AUTHORIZATION TO CONSTRUCT / OPERATION PERMIT / EXISTING SYSTEM INSPECTION

STATESVILLE 704-878-5305 MOORESVILLE 704-664-5281

50.00 + 3.19

PERMIT# 119334 PIN# 4626 21 2748.000 4626210720 DATE 4/1/05

OWNER OR CONTRACTOR Hans Baker PHONE: Business 704-201-4992 Home

ADDRESS 154 Pancyuela Dr. Mooresville, NC 28117

LOCATION 1100 TR Chuckwood Rd. lot on R before Indian Trail

SUBDIVISION Waterview Landing / SECTION LOT 5 LOT AREA 30,000 SITE CLASS PS DESIGN FLOW 480 L.T.A.R. .3

Septic Tank: 2@1000 Gallons: STB 794/794 Date 10/19/04 10/19

Pump Tank: Gallons: PT Date

Pump Make: Model Serial No.

Nitrification Field: No Fields 1 Square Feet 1200 Linear Feet 400

No Lines 4@100' Trench Width 3' Max Trench Bottom Depth 3' Gravel Depth NA

☒ New System ☐ Repair System Type: I, II, III, IV, V, VI

System Description: GRAVITY - 25% Reduced

Repair System Description: Same

Maintenance Agreement Required: ☐ Yes ☒ No

☒ House/Mod. Home No. Bedrooms 4

☐ Mobile Home No. Bathrooms 4

☐ Business No. Employees

☒ Other Bradley Pump - Bomt


☐ Slab ☐ Crawl Space ☒ Basement w/plumbing ☐ Basement wo/plumbing

Water Supply: ☒ Individual ☐ Public ☐ Community


Comments/Conditions:

Comments/Conditions: EZ FLOW INSTALLED

INITIAL SITE SKETCH (1"=50')

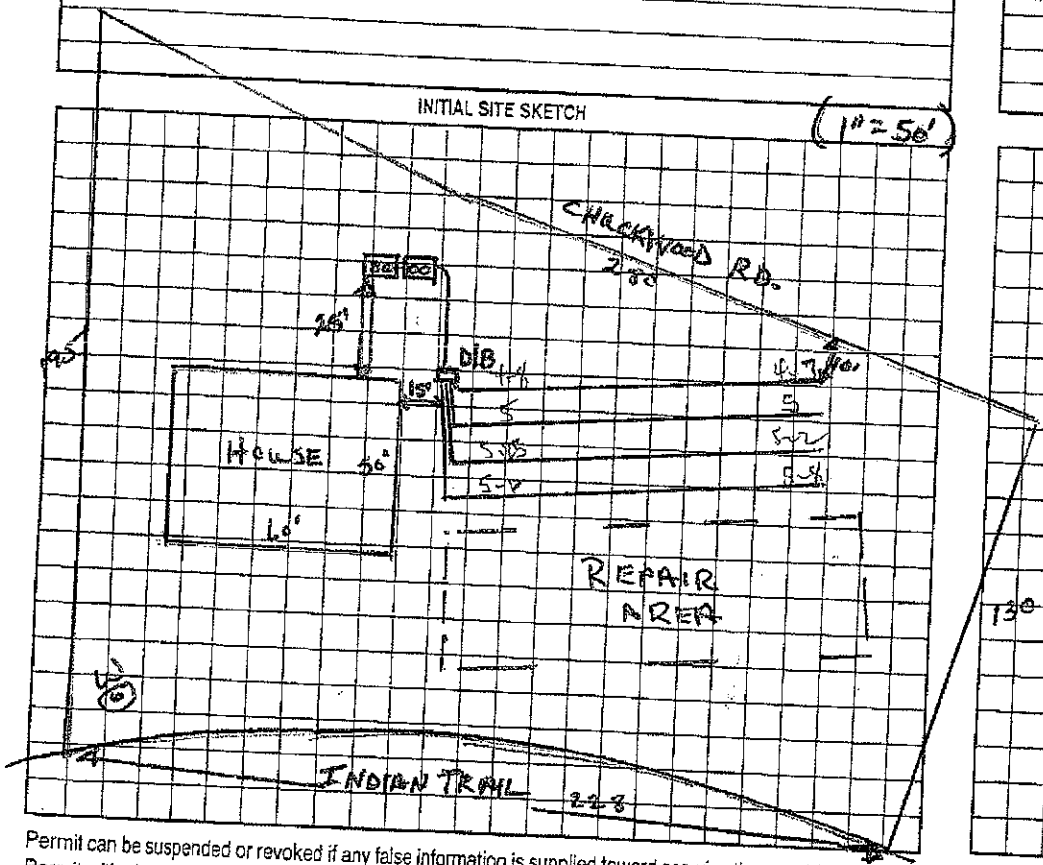


AS BUILT SKETCH

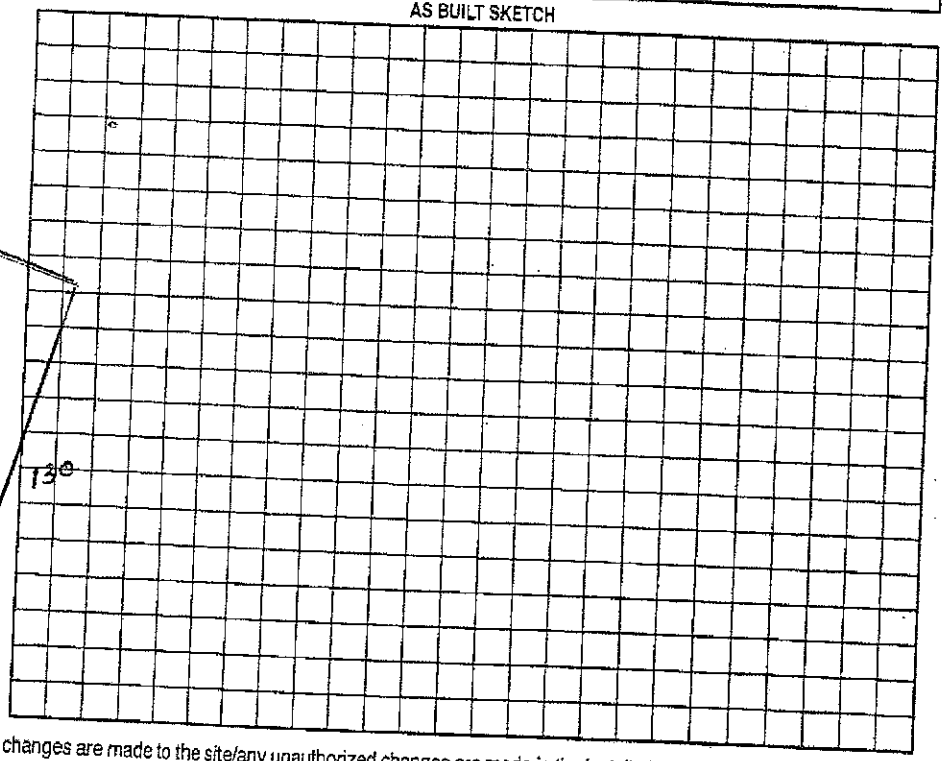


Permit can be suspended or revoked if any false information is supplied toward securing the permit/any unauthorized changes are made to the site/any unauthorized changes are made in the installation of the system. Improvement Permit with plat valid without expiration. Improvement Permit with site plan valid for sixty months. Authorization to Construct is valid for a period equal to that of Improvement Permit – not to exceed sixty months.

Signed: Hans Baker date 4-5-05

Improvement Permit by: Wesley Sparks RS. date 4/1/05

Authorization to Construct by: Wesley Sparks RS date 4/1/05

Installed by: Howards Backhoe

Operation Permit by: Wesley Sparks RS date 4/6/05

Existing System Inspection by: date

HEALTH DEPT. COPY: WHITE OWNER COPY (FINAL): YELLOW OWNER COPY (INITIAL): PINK