IREDELL COUNTY HEALTH DEPARTMENT

3-30

Statesville Office (704) 878-5305 Mooresville Office (704) 660-3625 PERMIT # 150188

IMPROVEMENT PERMIT / AUTHORIZATION TO CONSTRUCT / OPERATION PERMIT / EXISTING SYSTEM

PIN # 4676-71-1366

APPLICANT: LAKE LUXURY HOMES LLC APPLICANT ADDRESS: PO BOX 3792 MOORESVILLE, NC 28117

SITE ADDRESS: 377 CHUCKWOOD RD. MVILLE NC 28117 PHONE: 704-516-2344 ALT. PHONE:

SITE DIRECTIONS: BSR, CHUCKWOOD, ON L


SUBDIVISION: WATERTREE LANDING SECTION: LOT # 100 LOT AREA: .75AC DESIGN FLOW: 600 L.T.A.R.: .275

Septic Tank	1500	(gal)	STB	1014	Date	5-10-13	☒ New System	☐ Repair	☐ Expansion	System Type: I II ⓘ IV V VI	
Pump Tank		(gal)	PT		Date		System Description:			25% REDUCTION	
Pump Make			Model		Serial #		Repair System Description:			PANEL BLOCK	
# Nitrification Fields	1		# Lines	7	Linear Ft:	555'	Maintenance Agreement Required:	☐ YES	☒ NO		
Trench Width	36"		Max. Trench Bottom Depth	36"	Gravel Depth			☒ GRAVITY	☐ PRESSURE		


☒ Residence	No. Bedrooms	5	**Water Supply**		
☐ Business	No. Persons		☒ Private		
☐ Other	No. Employees		☐ Public		
☐ Slab	☐ Crawl Space		☐ Community		
☒ Basement w/plumbing			☐ Basement w/o plumbing		

Comments / Conditions:

INITIAL SITE SKETCH

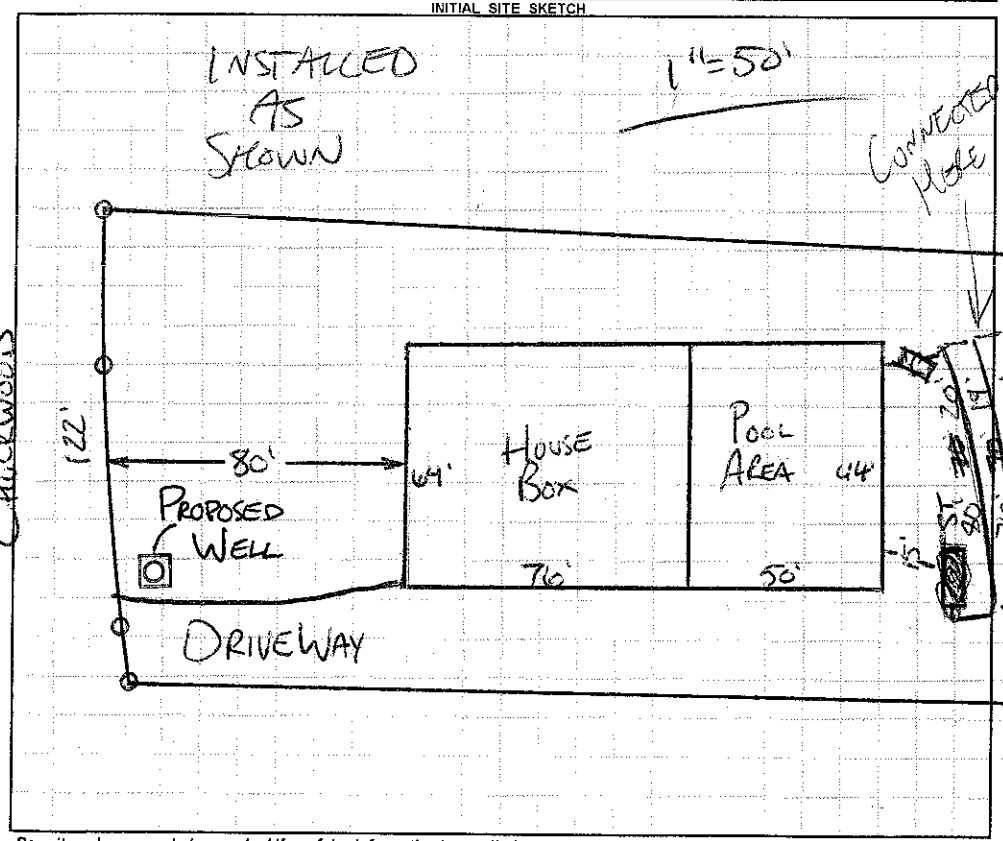

AS BUILT SKETCH

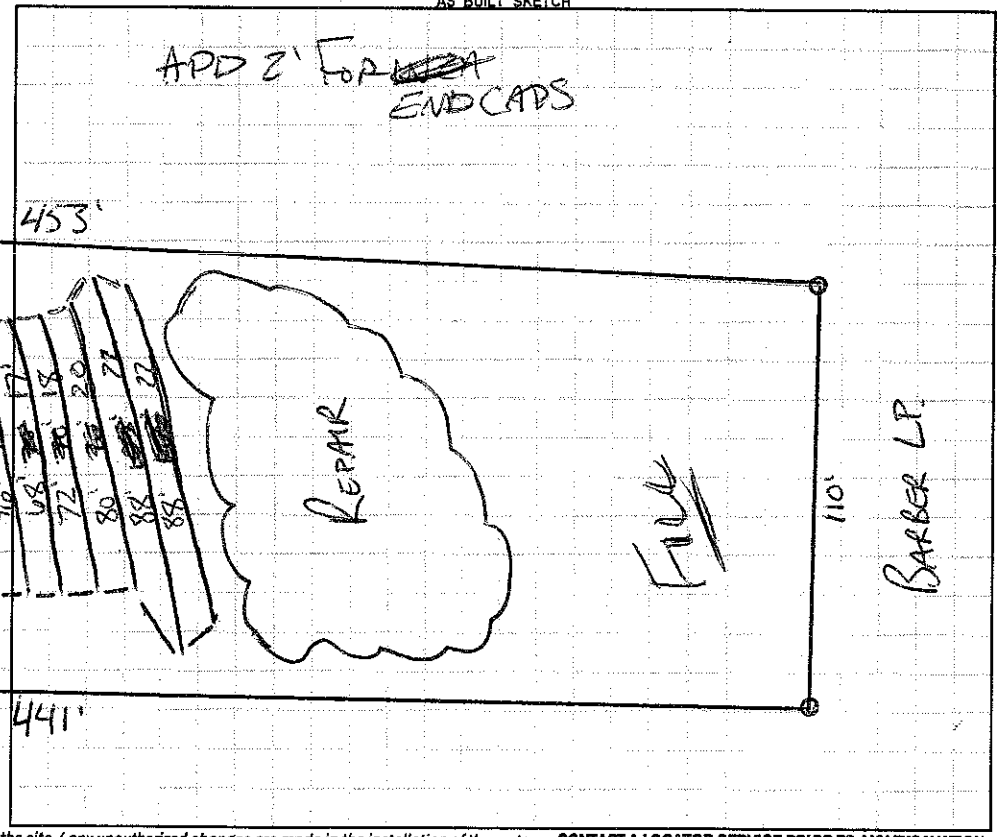

Permit can be suspended or revoked if any false information is supplied toward securing the permit / any unauthorized changes are made to the site / any unauthorized changes are made in the installation of the system. **CONTACT A LOCATOR SERVICE PRIOR TO ANY EXCAVATION**

☐ **IMPROVEMENT PERMIT** *with plat valid without expiration.* ☒ **IMPROVEMENT PERMIT** *with site plan valid for 60 mos.* ☒ **AUTHORIZATION TO CONSTRUCT** *valid for period equal to IMPROVEMENT PERMIT--not to exceed 60 mo.*

Owner / Applicant Signature: Date: 3/11/13 Installed by: BOWAN SEPTIC

IMPROVEMENT PERMIT by: Date: 2-15-13 OPERATION PERMIT by: Date: 7-24-13

AUTHORIZATION TO CONSTRUCT by: Date: 2-26-13 Existing System Inspected by: Date:

Health Dept. Copy - WHITE Applicant (Final Approval) - YELLOW Applicant (Conditional Approval) - PINK