IREDELL COUNTY HEALTH DEPARTMENT

Statesville Office (704) 878-5305 Mooresville Office (704) 660-3625 PERMIT # 210336

3:30 AZP

IMPROVEMENT PERMIT / AUTHORIZATION TO CONSTRUCT / OPERATION PERMIT / EXISTING SYSTEM

PIN # 4626212298

APPLICANT: Whitley Construction APPLICANT ADDRESS: 127 Hunters Pointe Ln Mooresville, NC 28117

SITE ADDRESS: 172 Barber Loop - Mooresville, NC PHONE: 704 658-9251 ALT. PHONE: 704 361-9879

SITE DIRECTIONS: Brawley School Rd TR Chuckwood TL Barber Loop on Right

SUBDIVISION: Watertree Landing SECTION: 5 LOT # 99 LOT AREA: .93 Acre DESIGN FLOW: 480 gpd L.T.A.R.: .25

Septic Tank 1000 (gal) STB 338 Date 1-18-16
Pump Tank 1000 (gal) PT 27 Date 11-30-15
Pump Make Zoeller Model WE0512HHC Serial # 6e1445
Nitrification Fields 1 # Lines 6 Linear Ft: 480
Trench Width 36" Max. Trench Bottom Depth 24" Gravel Depth N/A

[X] New System [ ] Repair [ ] Expansion System Type: I II (III) IV V VI
System Description: Pump-PM-25% Reduction
Repair System Description: Drip Irrigation
Maintenance Agreement Required: [ ] YES [X] NO [ ] GRAVITY [X] PRESSURE

[X] Residence No. Bedrooms 4
[ ] Business No. Persons 8
[ ] Other No. Employees
[ ] Slab [X] Crawl Space
[ ] Basement w/plumbing [ ] Basement w/o plumbing

Water Supply: [X] Private [ ] Public [ ] Community

Comments / Conditions:

CHECKED TANKS 2-22-16 BH
Used Quick 4 3/11/16 Checked lines MB
4/25/16 Set Pressure, checked float & alarm

INITIAL SITE SKETCH

See attached/approved plan by Soil & Forestry Services of the Carolinas, PA dated May 2015

AS BUILT SKETCH

Permit can be suspended or revoked if any false information is supplied toward securing the permit / any unauthorized changes are made to the site / any unauthorized changes are made in the installation of the system. **CONTACT A LOCATOR SERVICE PRIOR TO ANY EXCAVATION**

[ ] **IMPROVEMENT PERMIT** *with plat valid without expiration.* [X] **IMPROVEMENT PERMIT** *with site plan valid for 60 mos.* [X] **AUTHORIZATION TO CONSTRUCT** *valid for period equal to IMPROVEMENT PERMIT--not to exceed 60 mo.*

Owner / Applicant Signature: Date: 5/19/15 Installed by: HALLMAN

IMPROVEMENT PERMIT by: Maria Dotson RS Date: 5/19/15 OPERATION PERMIT by: Maria Dotson RS Date: 4/25/16

AUTHORIZATION TO CONSTRUCT by: Date: 5-19-15 Existing System Inspected by: Date:


Health Dept. Copy - WHITE Applicant (Final Approval) - YELLOW Applicant (Conditional Approval) - PINK

DAS DON ALLEN & ASSOCIATES, P. A.
"Since 1971"
Commercial * Residential * Mortgage Surveys * Multi-Family
Construction Staking * Subdivision Design * Topographical
131 Crossiake Park Drive – Suite 102 * Mooresville * NC * 28117
(704) 664–7029 (704) 664–8041 Fax

I, certify that this map was drawn under my supervision from an actual survey made under my supervision recorded in deed book_____, page_____, and/or plat book_____, page_____, that the ratio of precision is 1':10,000, that this map was prepared in accordance with the General Statutes of North Carolina Chapter 89C. my hand and seal on the 5, day of MAY, A.D. 20 15.

WILLIAM M. ALLEN, PLS

OK 3x20 5/19/15

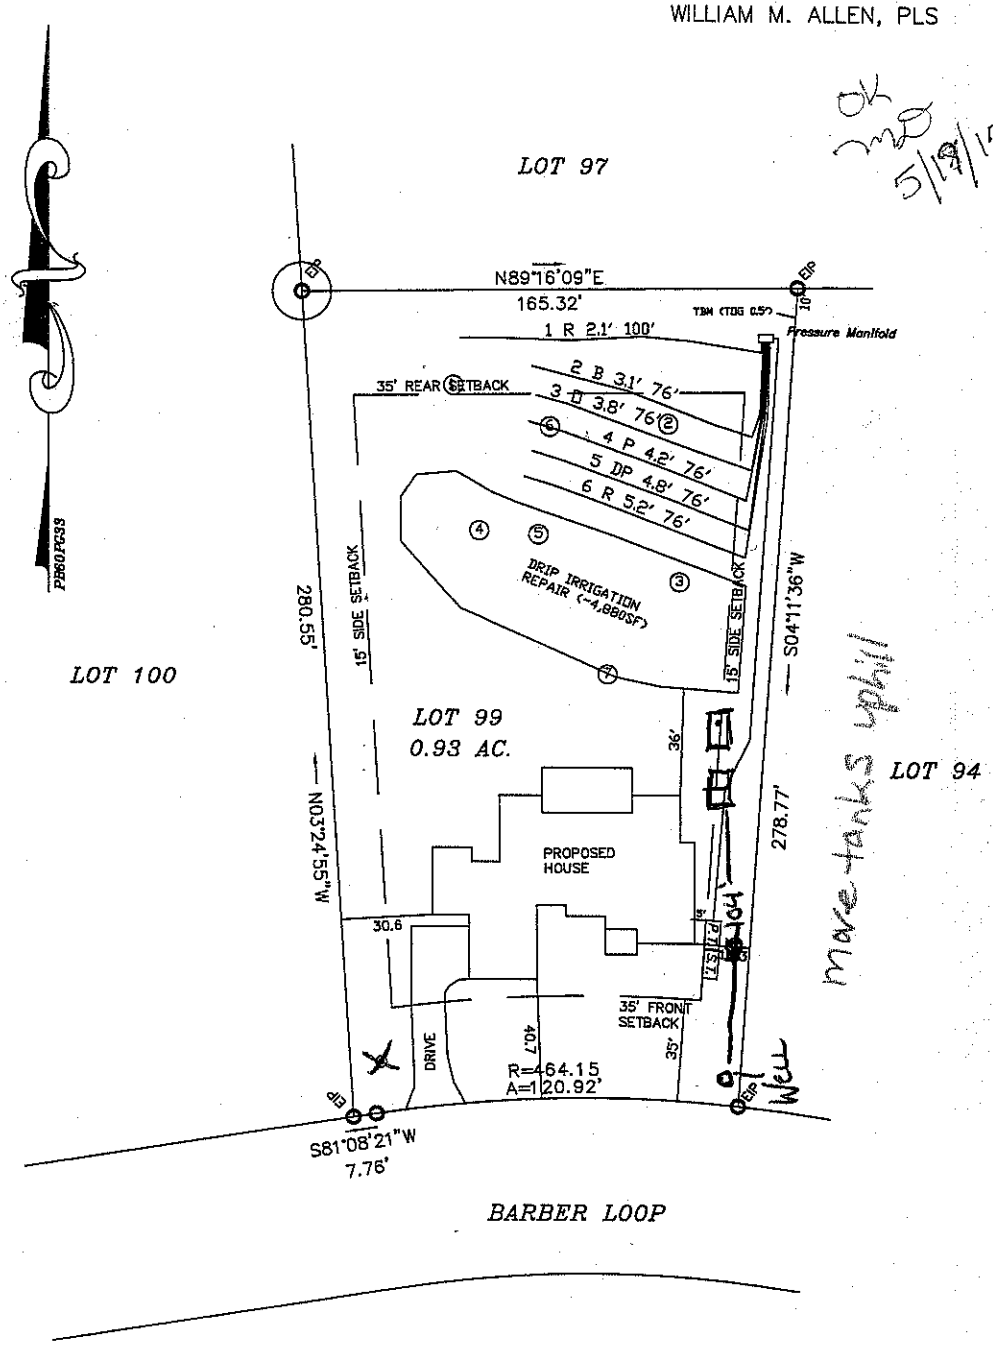

PLOT PLAN SURVEY

OF

172 BARBER LOOP

LOT 99 WATERTREE LANDING

SCALE 1" = 50' DAVIDSON TWSP., IREDELL CO., N.C.

ACQUIRED BY: BONOMO

FIELD BOOK:
FILE: WATERTREE LANDING 99
DC FILE:
TAX MAP NO: