IREDELL COUNTY HEALTH DEPARTMENT

Statesville Office (704) 878-5305 ALP Mooresville Office (704) 660-3625 PERMIT # 21812

IMPROVEMENT PERMIT / AUTHORIZATION TO CONSTRUCT / OPERATION PERMIT / EXISTING SYSTEM

PIN # 4626 212 788

APPLICANT: Benjamin & Amber Fairbanks APPLICANT ADDRESS: 370 Chuckwood Mooresville, NC 28117

SITE ADDRESS: 370 Chuckwood Mooresville, NC PHONE: ALT. PHONE: Michael Athanas 704 576-3887

SITE DIRECTIONS: Brawley School Rd TR Chuckwood on right past 1st Barber Lp.

SUBDIVISION: Waterfree Landing SECTION: 1 LOT # 2 LOT AREA: .689 Ac DESIGN FLOW: 480gpd L.T.A.R.: .3

Septic Tank	1000 (gal)	STB		Date		☒ New System	☐ Repair	☐ Expansion	System Type: I II III IV V VI	☒ Residence	No. Bedrooms 4
Pump Tank	(gal)	PT		Date		System Description: Gravity -25% Reduction				☐ Business	No. Persons 8
Pump Make		Model		Serial #		Repair System Description: PPAPS				☐ Other	No. Employees
# Nitrification Fields	1	# Lines	4	Linear Ft:	24'	Maintenance Agreement Required:	☐ YES	☒ NO		☐ Slab	☒ Crawl Space
Trench Width	36"	Max. Trench Bottom Depth	36"	Gravel Depth	N/A	☒ GRAVITY	☐ PRESSURE			☐ Basement w/plumbing	☐ Basement w/o plumbing

Water Supply: ☒ Private ☐ Public ☐ Community

Comments / Conditions: 4 existing, add 1 drainline to accomodate Setback to Patio/Outdoor Kitchen.

INITIAL SITE SKETCH

See approved/attached plan by Michael Athanas & Assoc. dated 7/6/15

AS BUILT SKETCH

Permit can be suspended or revoked if any false information is supplied toward securing the permit / any unauthorized changes are made to the site / any unauthorized changes are made in the installation of the system. **CONTACT A LOCATOR SERVICE PRIOR TO ANY EXCAVATION**

☐ **IMPROVEMENT PERMIT** *with plat valid without expiration.* ☒ **IMPROVEMENT PERMIT** *with site plan valid for 60 mos.* ☒ **AUTHORIZATION TO CONSTRUCT** *valid for period equal to IMPROVEMENT PERMIT--not to exceed 60 mo.*

Owner / Applicant Signature: [signature] Date: 7/16/15 Installed by: Wastewater Solutions

IMPROVEMENT PERMIT by: Maria Dotson RS Date: 7/14/15 OPERATION PERMIT by: [signature] Date: 8-5-15

AUTHORIZATION TO CONSTRUCT by: Maria Dotson RS Date: 7/14/15 Existing System Inspected by: Date:

Health Dept. Copy - WHITE Applicant (Final Approval) - YELLOW Applicant (Conditional Approval) - PINK

Lot 7
Lot 14
S86°40'38"E 101.04
APPROVED JUL 14 2015
35' Setback
Lot 2
30,036
Sq.Ft.
New Patio Area
Patio
Proposed House
N15°12'13"E 282.73
S09°45'52"W 255.72
20.3
34.0
15' Setback
15' Setback
27.5
35' Setback
DRIVE
Well
40.0
63.53
51.10
L1
S82°34'05"W
S86°22'09"W
Lot 6
Lot 1
Lot 5
R/W
P.B. 44, Pg. 86
Chuckwood Rd
GRAPHIC SCALE
60
0
30
60
120
240
(IN FEET)
1 inch = 50 ft.
Plot Plan
FOR
SCALE: 1" = 50'

IREDELL COUNTY HEALTH DEPARTMENT

STATESVILLE 704-878-5305 MOORESVILLE 704-664-5281

130.00 Pd

IMPROVEMENT PERMIT / AUTHORIZATION TO CONSTRUCT / OPERATION PERMIT / EXISTING SYSTEM INSPECTI

PERMIT# 119331 PIN# 4626-21-2848.002 DATE May 25, 04

OWNER OR CONTRACTOR Mid Atlantic Custom Builders PHONE: Business _____ Home _____

ADDRESS P.O. Box 3792, Mooresville, N.C. 28117

LOCATION Brawley School Rd. TR Chuckwood on right, just pst w/ Barber loop

SUBDIVISION Waterstree Landing BLOCK/SECTION _____ LOT 2 LOT AREA 30,036 ft² SITE CLASS PS DESIGN FLOW 480 gpd L.T.A.R. #3

Septic Tank: 1000 Gallons STB 1012 Date 6-8-05
Pump Tank: _____ Gallons PT _____ Date _____
Pump Make: _____ Model _____ Serial No. _____
Nitrification Field: No Fields 1 Square Feet 1200 Linear Feet 400
No Lines 4 Trench Width 36" Max Trench Bottom Depth 36"

☑ New System ☐ Repair System Type: I II III IV V VI
System Description: Gravity 25% Reduction
Repair System Description: Gravity/LP 25% Reduction
Maintenance Agreement Required: ☐ Yes ☑ No
Gravel Depth N/A

☑ House/Mod. Home No. Bedrooms 4
☐ Mobile Home No. Bathrooms 2.5
☐ Business No. Employees ____
☐ Other


☐ Slab ☑ Crawl Space ☐ Basement w/plumbing ☐ Basement wo/plumbing

Water Supply: ☑ Individual ☐ Public ☐ Community

Comments/Conditions:


Comments/Conditions:
Yellow tuf-tite filter
Septic tank w/marker

1"=50' INITIAL SITE SKETCH

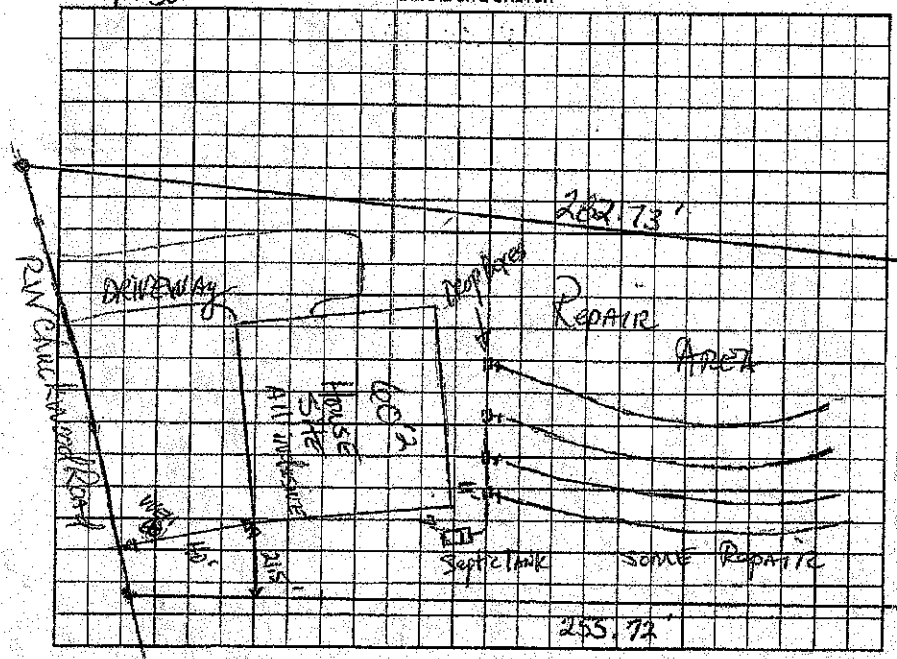

AS BUILT SKETCH

Installed Quick 4 std. Chamber
4 lines 96', 96', 104', 100'
as per initial
site sketch

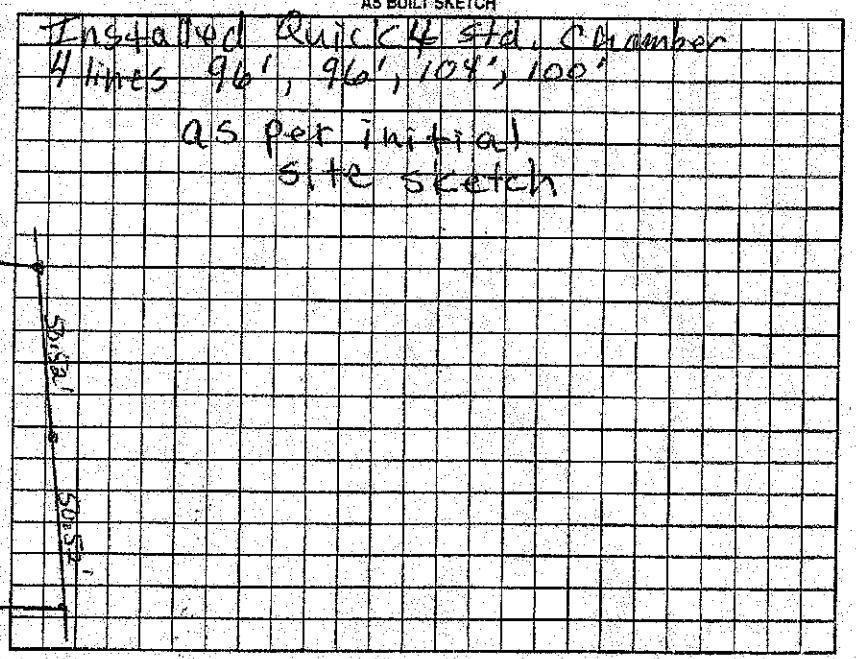

Permit can be suspended or revoked if any false information is supplied toward securing the permit/any unauthorized changes are made to the site/any unauthorized changes are made in the installation of the system. Improvement Permit with plat valid without expiration. Improvement Permit with site plan valid for sixty months. Authorization to Construct is valid for a period equal to that of Improvement Permit – not to exceed sixty months.

Signed: George Bethune date 5-27-04 Installed by: Craig Thompson

Improvement Permit by: D. Hoffman, LRS date 5-25-04 Operation Permit by: Judy McMillan date 2-3-06

Authorization to Construct by: D. Hoffman, LRS date 5-25-04 Existing System Inspection by: _____ date _____

HEALTH DEPT. COPY: WHITE OWNER COPY (FINAL): YELLOW OWNER COPY (INITIAL): PINK