IREDELL COUNTY HEALTH DEPARTMENT

4626214717

STATESVILLE 704-878-5305 MOORESVILLE 704-664-5281

130.00 paid 10-04

IMPROVEMENT PERMIT / AUTHORIZATION TO CONSTRUCT / OPERATION PERMIT / EXISTING SYSTEM INSPECTION

PERMIT# 119330 PIN# 4626-21-2748.001 4626214717

OWNER OR CONTRACTOR Mid-Atlantic Custom Builders PHONE: Business 704-871-1894 Home

ADDRESS PO Box 3792 Mooresville NC 28117 DATE 4/6/04

LOCATION BSR, TR Chuckwood on RT #364 Chuckwood

SUBDIVISION Waterfree Landing BLOCK / SECTION LOT 1 LOT AREA 30,162 ft² SITE CLASS PS DESIGN FLOW 480 L.T.A.R. 0.3

Septic Tank: 1000 Gallons; STB 312 Date 9/24/04

Pump Tank: Gallons; PT Date

Pump Make: Model Serial No.

Nitrification Field: No Fields 1 Square Feet 1200 Linear Feet 400

No Lines 4 Trench Width 36" Max Trench Bottom Depth 36" Gravel Depth —

☒ New System ☐ Repair System Type: I, II, (III), IV, V, VI

System Description: Gravity 25% Reduction

Repair System Description: Pump Panel Block

Maintenance Agreement Required: ☐ Yes ☒ No

☒ House/Mod. Home ☐ Mobile Home ☐ Business ☐ Other

No. Bedrooms 4 No. Bathrooms 3 No. Employees

Water Supply: ☒ Individual ☐ Public ☐ Community


☐ Slab ☒ Crawl Space ☐ Basement w/plumbing ☐ Basement wo/plumbing

Comments:/Conditions:


1" = 40'

Comments:/Conditions:

INITIAL SITE SKETCH

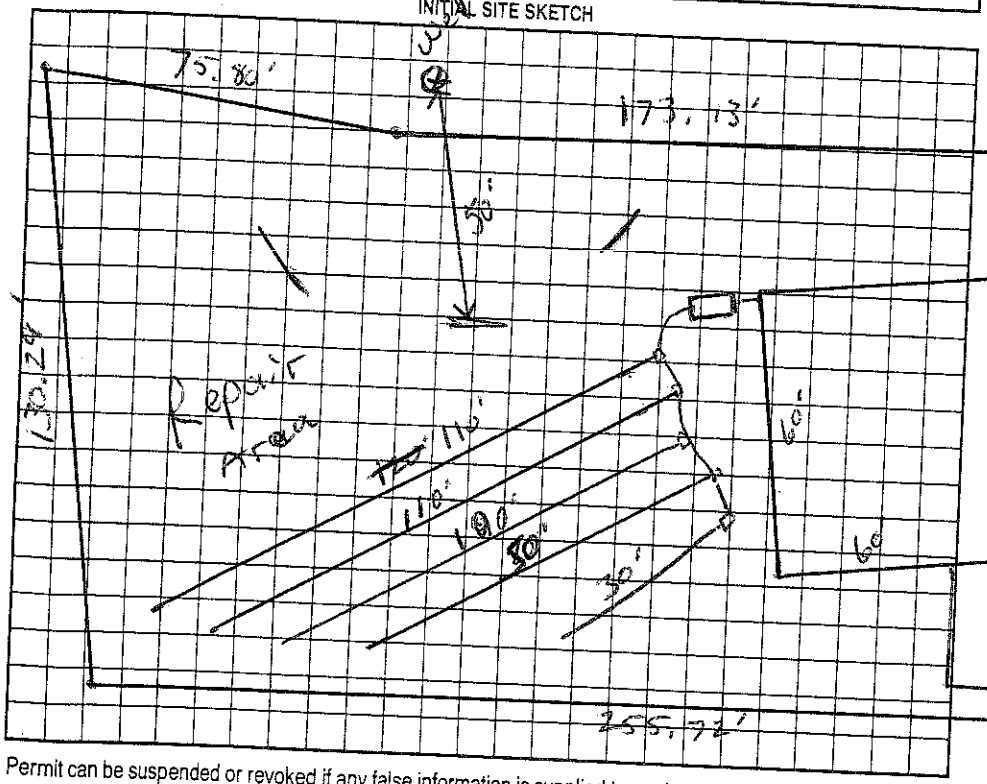

AS BUILT SKETCH

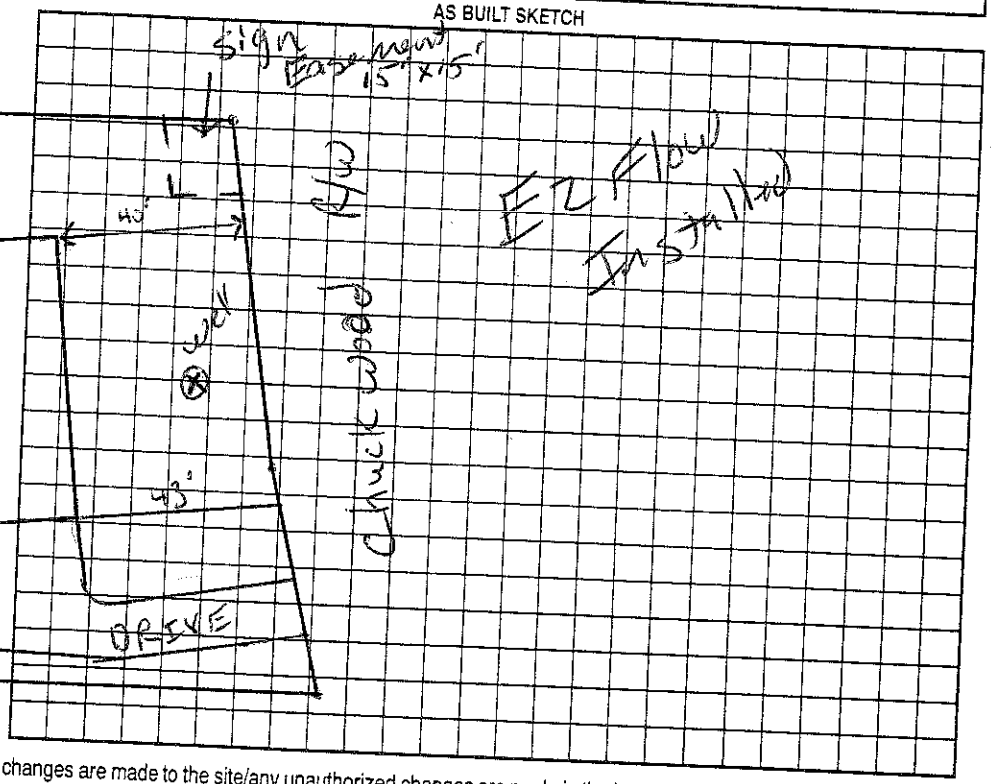

Permit can be suspended or revoked if any false information is supplied toward securing the permit/any unauthorized changes are made to the site/any unauthorized changes are made in the installation of the system. Improvement Permit with plat valid without expiration. Improvement Permit with site plan valid for sixty months. Authorization to Construct is valid for a period equal to that of Improvement Permit – not to exceed sixty months.

Signed: Doug Bethune date 5-27-04

Improvement Permit by: RS date 4/6/04

Authorization to Construct by: RS date 4/6/04

Installed by: Howard's Backhoe

Operation Permit by: RS date 1/12/05

Existing System Inspection by: date

HEALTH DEPT. COPY: WHITE OWNER COPY (FINAL): YELLOW OWNER COPY (INITIAL): PINK