IREDELL COUNTY HEALTH DEPARTMENT

STATESVILLE 704-878-5305 MOORESVILLE 704-664-5281

IMPROVEMENT PERMIT / AUTHORIZATION TO CONSTRUCT / OPERATION PERMIT / EXISTING SYSTEM INSPECTION

PERMIT # 150144 PIN # 4616-21-5767 DATE 6-25-12

OWNER or APPLICANT LAKE LUXURY HOMES PHONE: Business 704-516-2344 Home:

OWNER or APPLICANT ADDRESS PO BOX 3792 MOORESVILLE 158 Barber Lp

LOCATION / DIRECTIONS BSR, TR CHUCKWOOD, TL BARBER LOOP, ON R

SUBDIVISION WATERTREE LANDING BLOCK / SECTION LOT # 93 LOT AREA .76AC DESIGN FLOW 480 L.T.A.R. .25

Septic Tank 1000 Gallons: STB 794 Date 7-30-12

Pump Tank 1000 Gallons: PT 77 Date 7-16-12

Pump Make GOULDS Model WE0311M Serial #

Nitrification Field No Fields 1 No Lines 6 Linear Feet 480'

Trench Width 36" Max. Trench Bottom Depth 36" Gravel Depth —

☒ New System ☐ Repair ☐ Expansion System Type I II III IV V VI

System Description: PM - 25% REDUCTION

Repair System Description: SAME

Maintenance Agreement Required ☐ YES ☒ NO

☐ GRAVITY ☒ PRESSURE

☒ Residence No. Bedrooms 4

☐ Business No. Persons

☐ Other No. Employees

☐ Slab ☒ Crawl Space


☐ Basement w/plumbing ☐ Basement w/o plumbing

Water Supply: ☒ Private ☐ Public ☐ Community


Comments / Conditions

Comments / Conditions ① FILL WILL NEED TO BE REMOVED FOR REPAIR IN THE FUTURE ② OK TO USE 3 TAPS (3/4 SCH. 40) 11/7/12 MEMAIX Box only 3" above (not 6" above grade)

INITIAL SITE SKETCH

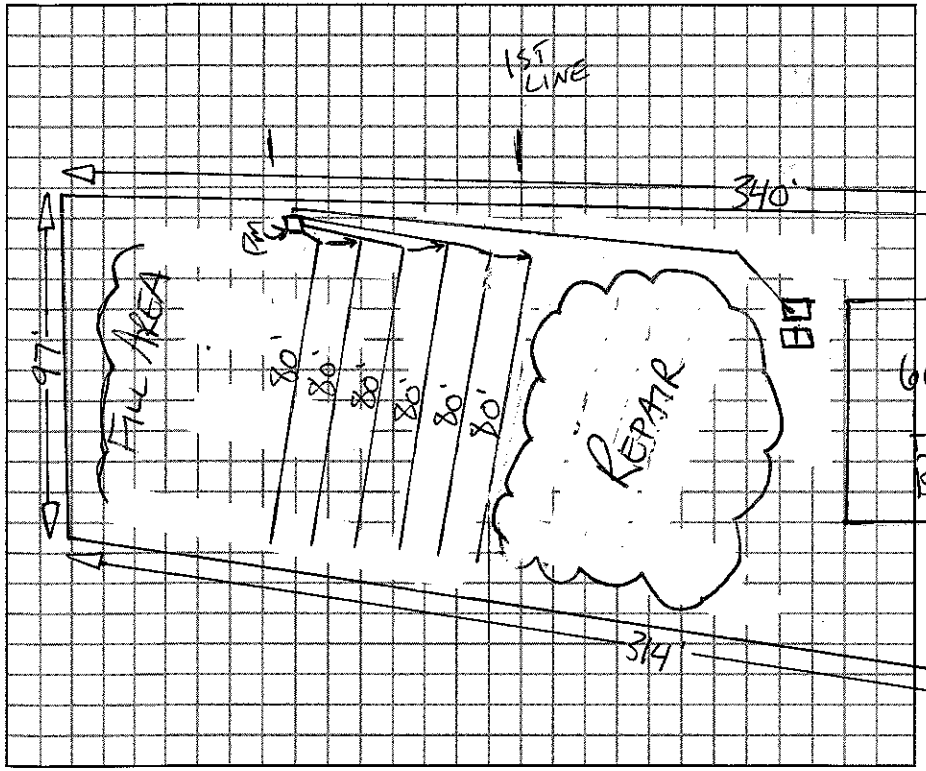

AS-BUILT SKETCH

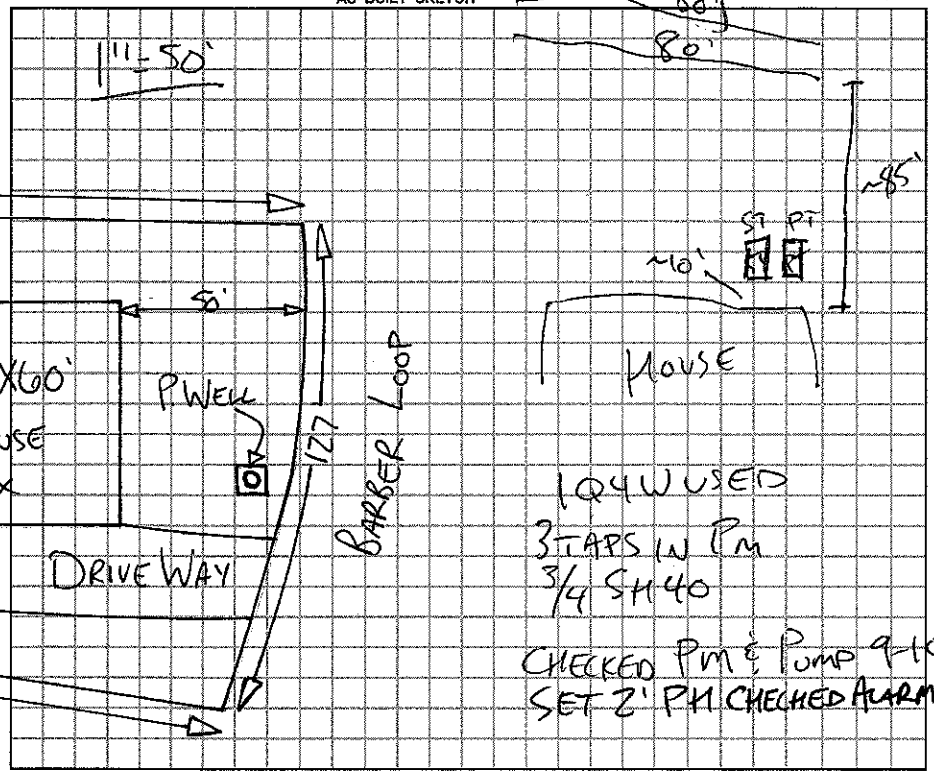

Permit can be suspended or revoked if any false information is supplied toward securing the permit / any unauthorized changes are made to the site / any unauthorized changes are made in the installation of the system.

☐ *IMPROVEMENT PERMIT w / plat valid without expiration.* ☐ *IMPROVEMENT PERMIT w / site plan valid for 60 mos.* ☒ ~~AUTHORIZATION~~ *TO CONSTRUCT valid for period equal to IMPROVEMENT PERMIT-not to exceed 60 mo.*

Owner / Applicant Signature: [signature] Date 6-25-12

Improvement Permit by: [signature] REHS Date 6-25-12

Authorization to Construct by: [signature] REHS Date 6-25-12

YOU SHOULD CONTACT A LOCATOR SERVICE PRIOR TO ANY EXCAVATION.

Installed by: WASTEWATER SOLUTIONS

Operation Permit by: [signature] Date: 11-26-12

Existing System Inspected by: Date:

WHITE COPY Environmental Health YELLOW COPY (Final) Owner / Applicant PINK COPY (Initial) Owner / Applicant