IREDELL COUNTY HEALTH DEPARTMENT

Statesville Office (704) 878-5305 Mooresville Office (704) 660-3625 PERMIT # 176224

IMPROVEMENT PERMIT / AUTHORIZATION TO CONSTRUCT / OPERATION PERMIT / EXISTING SYSTEM

PIN # 4626-21-6287

APPLICANT: LAKE LUXURY HOMES APPLICANT ADDRESS: PO BOX 3792 MOORESVILLE, NC

SITE ADDRESS: 152 BARBER LOOP PHONE: 704-516-2344 ALT. PHONE:

SITE DIRECTIONS: BSR, TR CHUCKWOOD, TL BARBER, ON R

SUBDIVISION: WATERTREE LANDING SECTION: 5 LOT # 92 LOT AREA: .8 AC DESIGN FLOW: 480 L.T.A.R.: .3

Septic Tank 1000 (gal) STB 825 Date

Pump Tank (gal) PT Date

Pump Make Model Serial #

Nitrification Fields 1 # Lines 5 Linear Ft: 400'

Trench Width 36" Max. Trench Bottom Depth 36" Gravel Depth —

☒ New System ☐ Repair ☐ Expansion System Type: I II (III) IV V VI

System Description: 25% RED.

Repair System Description: SAME (PM)

Maintenance Agreement Required: ☐ YES ☒ NO

☒ GRAVITY ☐ PRESSURE

☒ Residence ☐ Business ☐ Other ☐ Slab ☐ Basement w/plumbing


No. Bedrooms 4 No. Persons No. Employees

☒ Crawl Space ☐ Basement w/o plumbing


Water Supply
☒ Private ☐ Public ☐ Community

Comments / Conditions: * TANK MUST BE INSTALLED WHERE SHOWN TO GET GRAVITY FLOW *

INITIAL SITE SKETCH

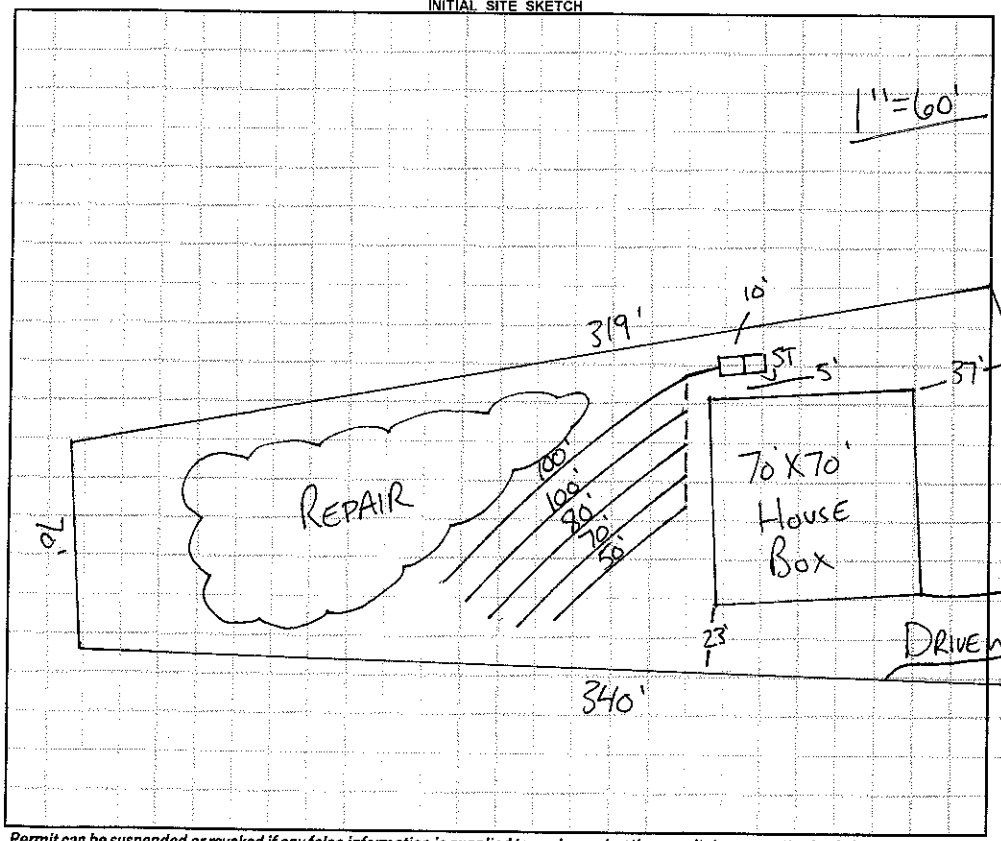

AS BUILT SKETCH

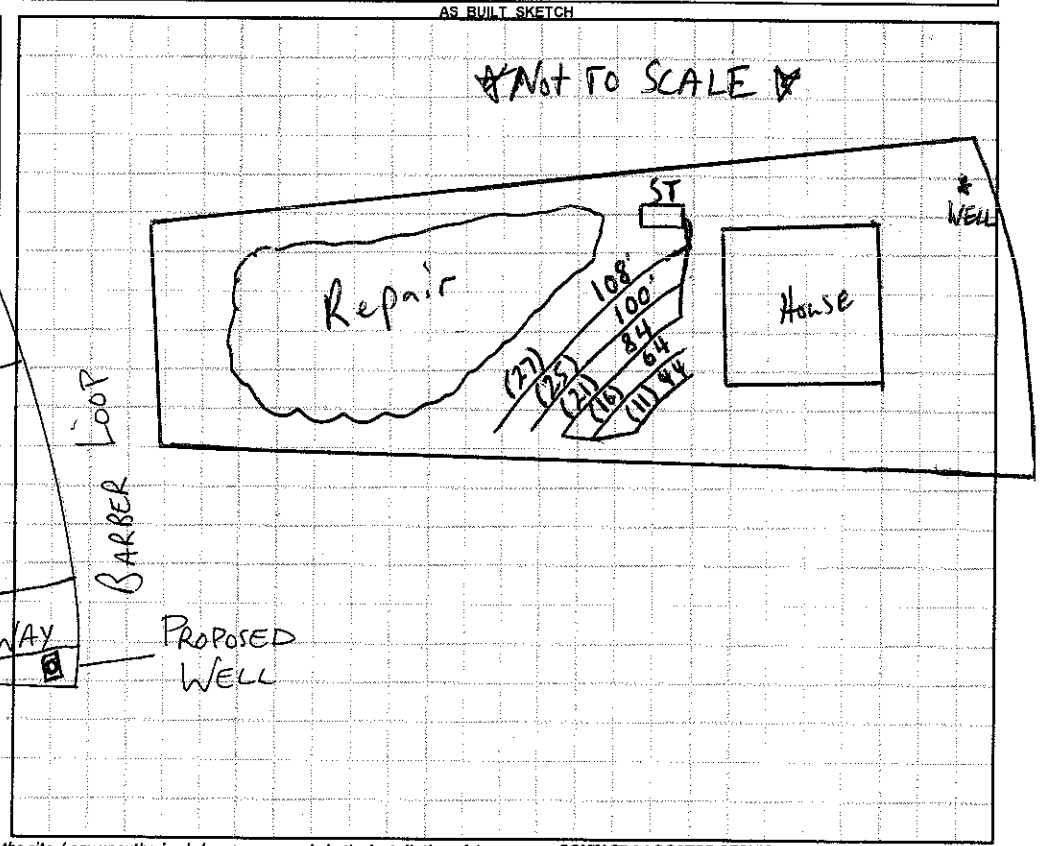

Permit can be suspended or revoked if any false information is supplied toward securing the permit / any unauthorized changes are made to the site / any unauthorized changes are made in the installation of the system. **CONTACT A LOCATOR SERVICE PRIOR TO ANY EXCAVATION**

☐ **IMPROVEMENT PERMIT** *with plat* valid without expiration. ☐ **IMPROVEMENT PERMIT** *with site plan* valid for 60 mos. ☒ **AUTHORIZATION TO CONSTRUCT** valid for period equal to IMPROVEMENT PERMIT--not to exceed 60 mo.

Owner / Applicant Signature: Date: 5/30/13 Installed by: Rowan Septic Tank

IMPROVEMENT PERMIT by: Date: 5-23-13 OPERATION PERMIT by: Date: 12-2-13

AUTHORIZATION TO CONSTRUCT by: Date: 5-23-13 Existing System Inspected by: Date:

Health Dept. Copy - WHITE Applicant (Final Approval) - YELLOW Applicant (Conditional Approval) - PINK