IREDELL COUNTY HEALTH DEPARTMENT

Statesville Office (704) 878-5305 Mooresville Office (704) 660-3625 PERMIT # 176217

IMPROVEMENT PERMIT / AUTHORIZATION TO CONSTRUCT / OPERATION PERMIT / EXISTING SYSTEM

PIN # 4626219316

APPLICANT: Lake Luxury Homes APPLICANT ADDRESS: Po Box 3792 Mooresville 28117

SITE ADDRESS: 140 Barber LP PHONE: 704-516-2344 ALT. PHONE:

SITE DIRECTIONS: BSR, Chuckwood, Barber, on R

SUBDIVISION: Watertree Landing SECTION: LOT # 90 LOT AREA: 1.37 AC DESIGN FLOW: 480 L.T.A.R.: .275

Septic Tank	1000	(gal)	STB	794	Date	5-4-13	☒ New System	☐ Repair	☐ Expansion	System Type: I II (III) IV V VI	
Pump Tank		(gal)	PT		Date		System Description:	25% Reduction			
Pump Make		Model			Serial #		Repair System Description:	Panel Block			
# Nitrification Fields	1	# Lines	4		Linear Ft:	456'	Maintenance Agreement Required:	☐ YES	☒ NO		
Trench Width	36"	Max. Trench			36"		Gravel Depth	—	☒ GRAVITY	☐ PRESSURE	

☒ Residence ☐ Business ☐ Other ☐ Slab ☐ Basement w/plumbing


No. Bedrooms 4 No. Persons No. Employees ☒ Crawl Space

☐ Basement w/o plumbing


Water Supply: ☒ Private ☐ Public ☐ Community

Comments / Conditions:

INITIAL SITE SKETCH

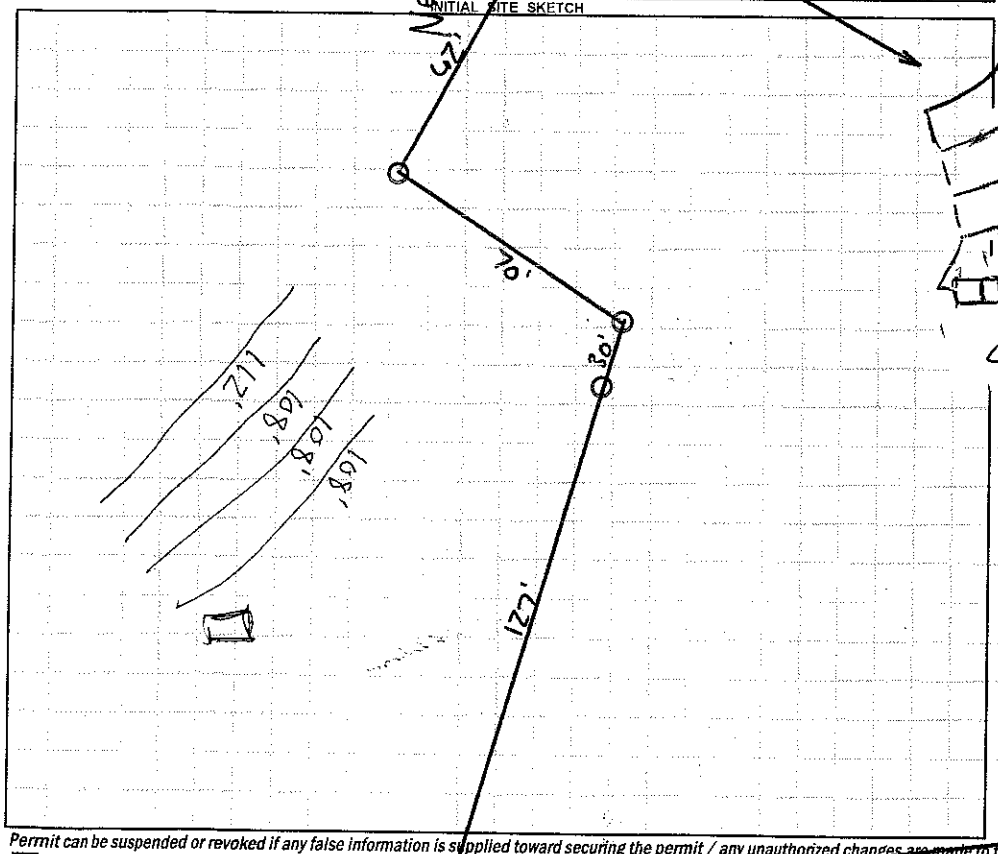

AS BUILT SKETCH

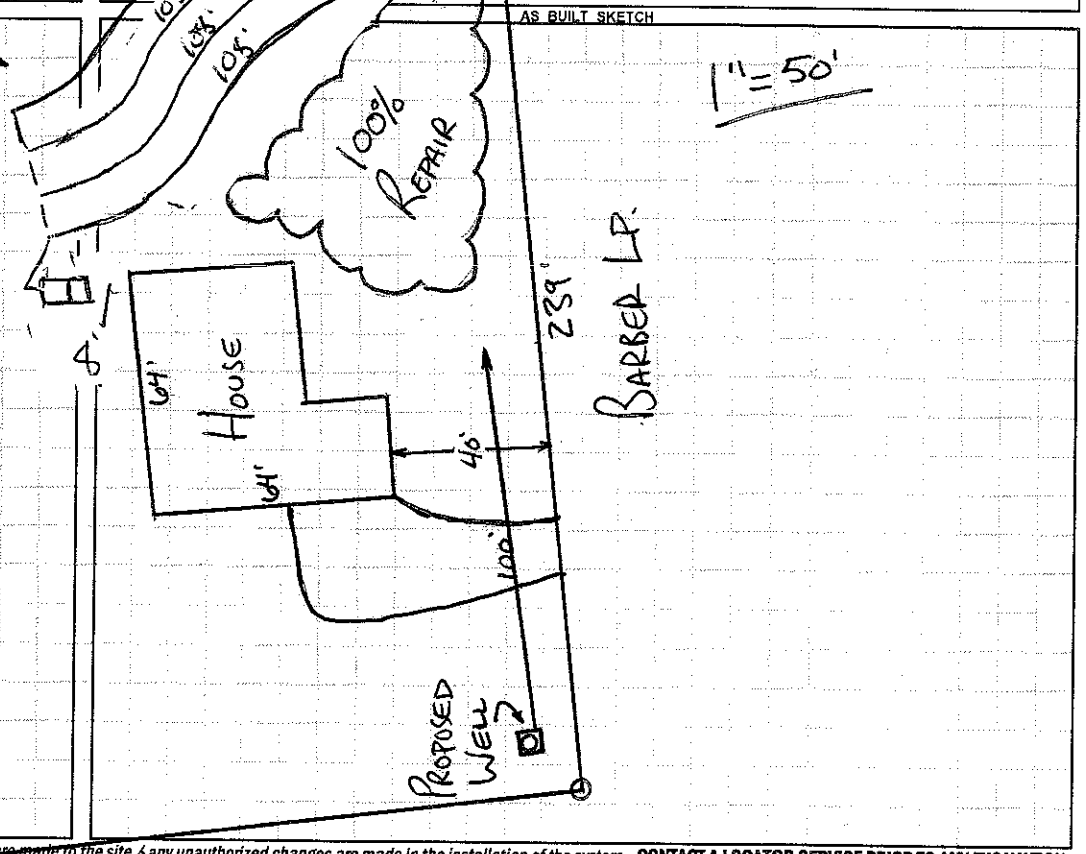

Permit can be suspended or revoked if any false information is supplied toward securing the permit / any unauthorized changes are made to the site / any unauthorized changes are made in the installation of the system. **CONTACT A LOCATOR SERVICE PRIOR TO ANY EXCAVATION**

☐ **IMPROVEMENT PERMIT** *with plat valid without expiration.* ☑ **IMPROVEMENT PERMIT** *with site plan valid for ~~60 mos.~~ 30* ☒ **AUTHORIZATION TO CONSTRUCT** *valid for period equal to IMPROVEMENT PERMIT--not to exceed 60 mo.*

Owner / Applicant Signature: Date: 2/19/13 Installed by: Waste Water Solutions

IMPROVEMENT PERMIT by: Date: 2-8-13 OPERATION PERMIT by: Date: 6-12-13

AUTHORIZATION TO CONSTRUCT by: Date: 2-8-13 Existing System Inspected by: Date:

Health Dept. Copy - WHITE Applicant (Final Approval) - YELLOW Applicant (Conditional Approval) - PINK