IREDELL COUNTY HEALTH DEPARTMENT

Statesville Office (704) 878-5305 | Mooresville Office (704) 660-3625 | PERMIT # 205497

IMPROVEMENT PERMIT / AUTHORIZATION TO CONSTRUCT / OPERATION PERMIT / EXISTING SYSTEM

PIN # 4626-21-9689

APPLICANT: LAKE LUXURY HOMES | APPLICANT ADDRESS:

SITE ADDRESS: 332 CHUCKWOOD RD. | PHONE: 704-578-4951 | ALT. PHONE:

SITE DIRECTIONS: RSR, TR CHUCKWOOD RD, ON R

SUBDIVISION: HOLIDAY HARBOR | SECTION: | LOT # 97 | LOT AREA: .81 AC | DESIGN FLOW: 480 | L.T.A.R.: .275

Septic Tank	1000	(gal)	STB	825	Date	6-12-15	☒ New System	☐ Repair	☐ Expansion	System Type: I II (III) IV V VI	
Pump Tank		(gal)	PT		Date		System Description:			25% REDUCTION	
Pump Make			Model		Serial #		Repair System Description:			PANEL BLOCK	
# Nitrification Fields	1		# Lines	4	Linear Ft:	438'	Maintenance Agreement Required:	☐ YES	☒ NO		
Trench Width	36"		Max. Trench Bottom Depth	30"	Gravel Depth	—		☒ GRAVITY	☐ PRESSURE		

☒ Residence	No. Bedrooms	4	Water Supply
☐ Business	No. Persons		☒ Private
☐ Other	No. Employees		☐ Public
☐ Slab	☒ Crawl Space		☐ Community
☐ Basement w/ plumbing			☐ Basement w/o plumbing

Comments / Conditions: WELL MUST BE ABANDONED BEFORE AC

INITIAL SITE SKETCH


SEE PLAN FROM KATHLEEN SAUNDERS

AS BUILT SKETCH

IQ4W INSTALLED

-107 Chambers Total

LINE	# of Chambers
1	15
2	21
3	31 total (15, 16)
4	40

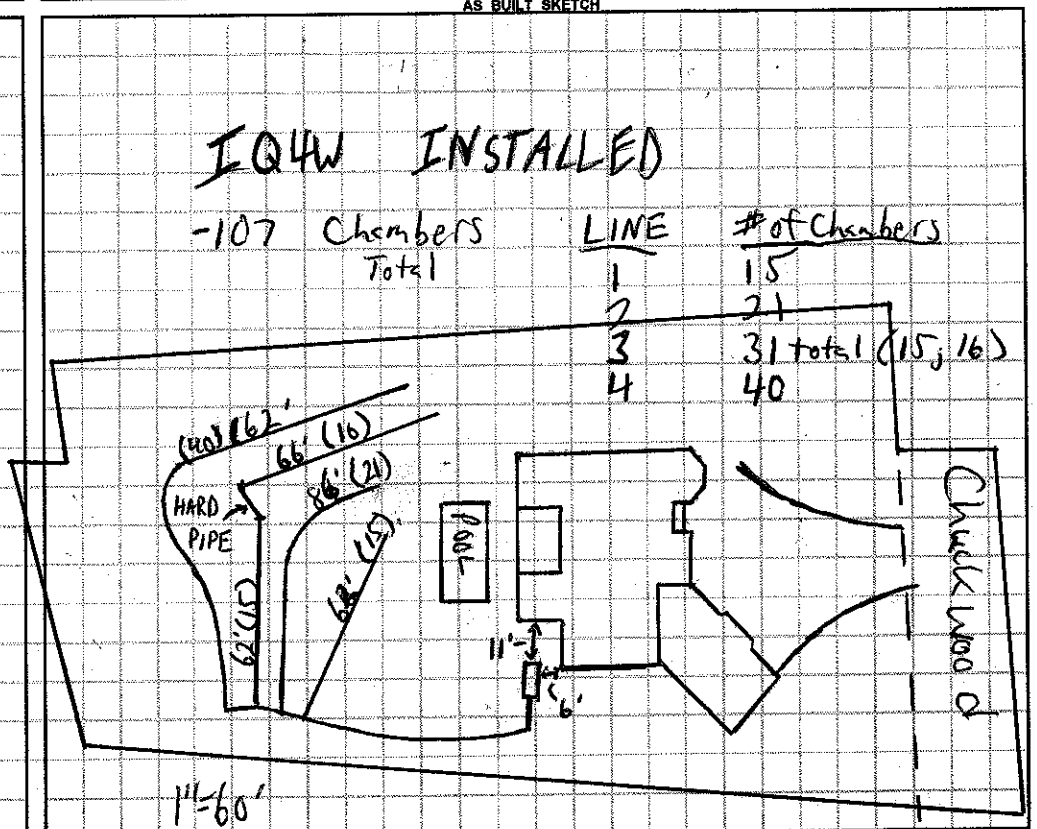

Permit can be suspended or revoked if any false information is supplied toward securing the permit / any unauthorized changes are made to the site / any unauthorized changes are made in the installation of the system. **CONTACT A LOCATOR SERVICE PRIOR TO ANY EXCAVATION**


☐ **IMPROVEMENT PERMIT** *with plat valid without expiration.* ☒ **IMPROVEMENT PERMIT** *with site plan valid for 60 mos.* ☒ **AUTHORIZATION TO CONSTRUCT** *valid for period equal to IMPROVEMENT PERMIT--not to exceed 60 mo.*

Owner / Applicant Signature: Kathleen Saunders | Date: 6/8/15 | Installed by: ROWAN

IMPROVEMENT PERMIT by: KAllis | APPROVED JUN 05 2015 | OPERATION PERMIT by: | Date: 9-21-15

AUTHORIZATION TO CONSTRUCT by: KAllis | Date: 6-5-15 | Existing System Inspected by: | Date:

Health Dept. Copy - WHITE | Applicant (Final Approval) - YELLOW | Applicant (Conditional Approval) - PINK

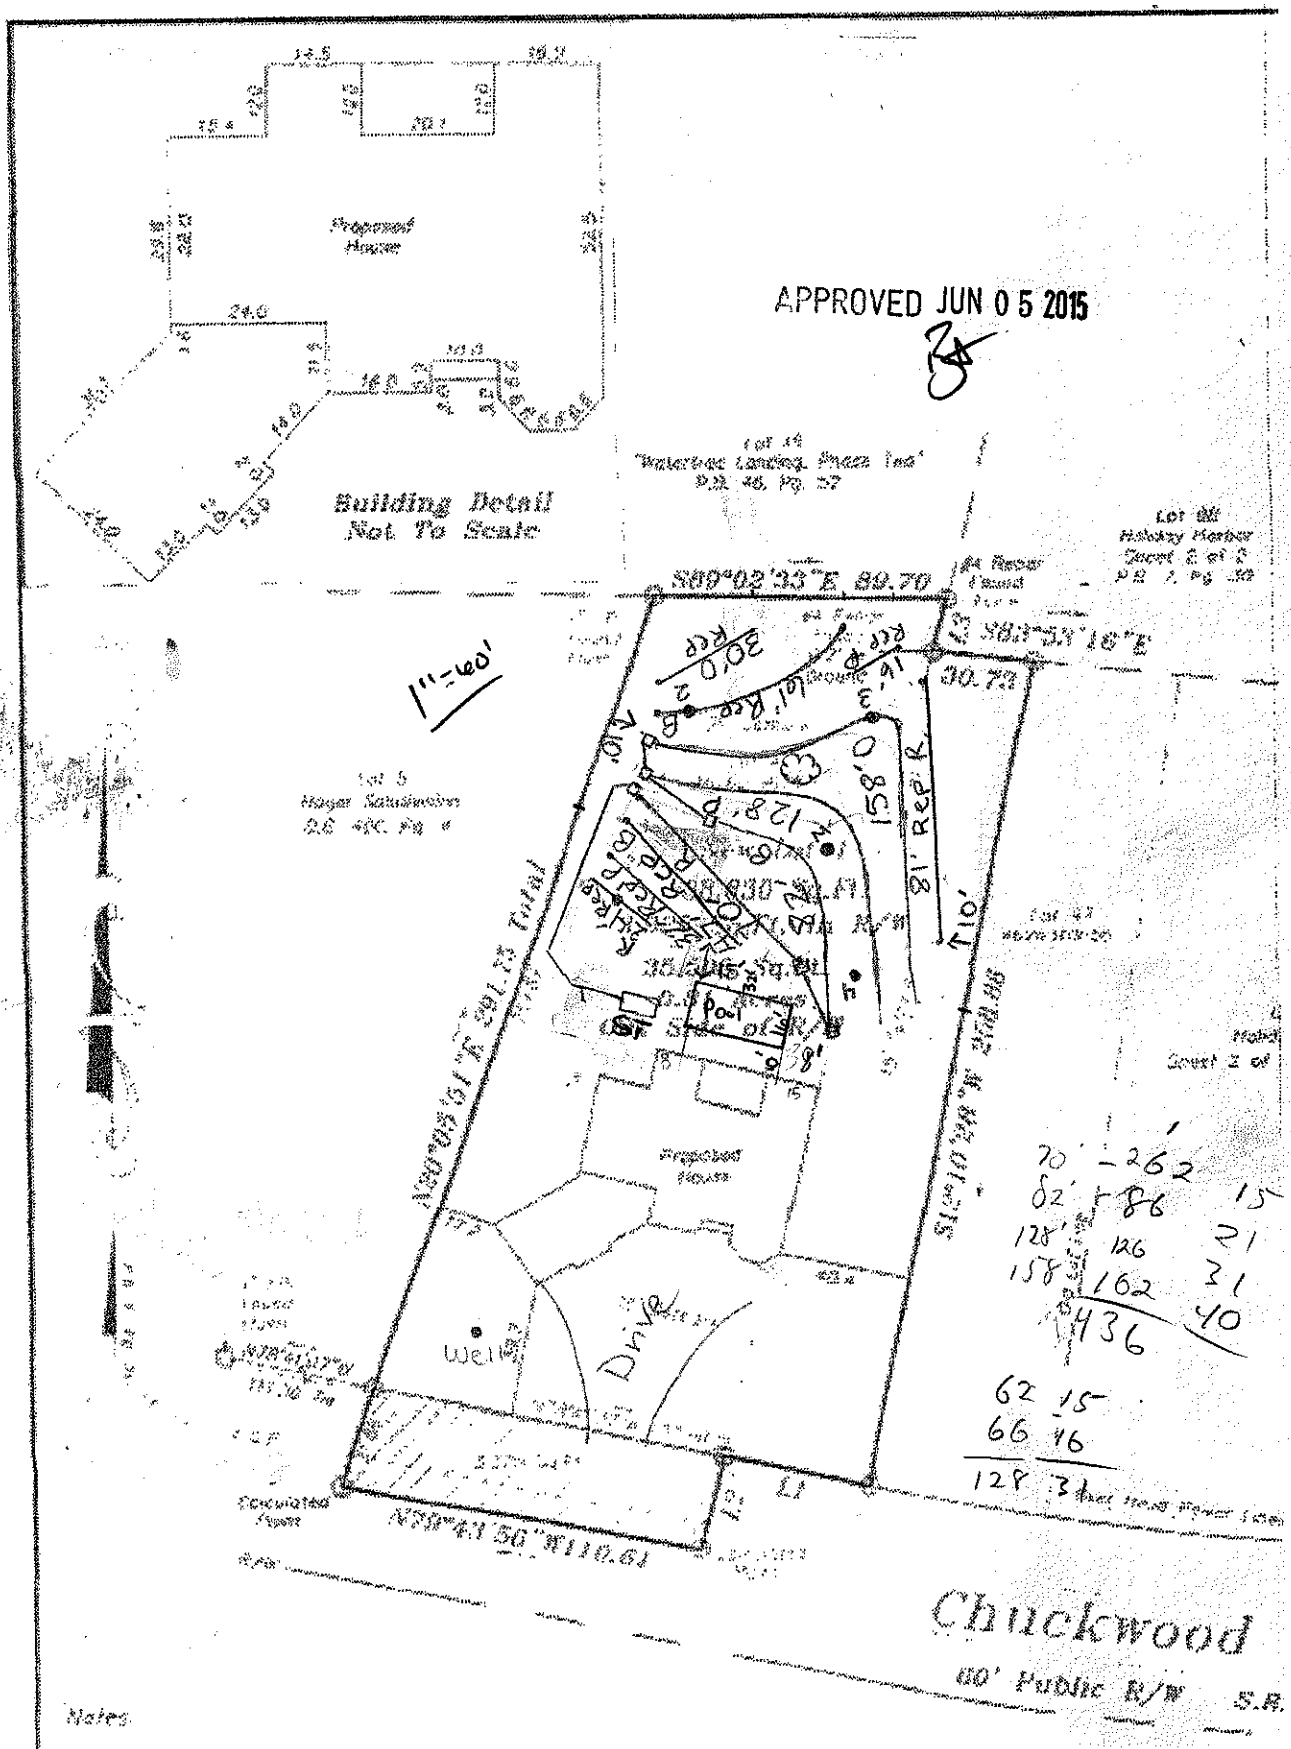

Notes:

1) This property may be subject to any Easements, Rights of-way, and/or Restrictive Covenants.

2) Boundary information based on Plat Book 7 at Page 30 and Deed Book 406, at Page 4 as recorded in the Knobel County Register of Deeds.

3) This survey is of an existing parcel or parcels of land.

4) No N.G.S. or U.S.G.N. Monuments