IREDELL COUNTY HEALTH DEPARTMENT

STATESVILLE 704-878-5305 MOORESVILLE 704-664-5281

IMPROVEMENT PERMIT / CERTIFICATE OF COMPLETION / OPERATION PERMIT / EXISTING SYSTEM INSPECTION

PROPERTY DESCRIPTION NO. 17374 DATE Nov. 2, '93 TAX MAP NO: 2E1A37 4626226121 Watershed: ☑ Yes ☐ No

OWNER OR CONTRACTOR William L. Elrod PHONE: Business _____ Home 664-6081 L.N.

ADDRESS 146, Box 463-Y, Mooresville

LOCATION 1100 TR 1177 to End TR Indian TRAIL .5 mile on left

SUBDIVISION Crescent Lk BLOCK / SECTION 7 LOT 1673 LOT AREA 20,000 ± sq ft SITE CLASS. _____ DESIGN FLOW 360 L.T.A.R. _____

Septic Tank: Existing Gallons; STB _____ Date _____

Pump Tank: Existing Gallons; PT _____ Date _____

Pump Make: _____ Model _____ Serial No. _____

Nitrification Field: No Fields 1 Square Feet 1035 Linear Feet 345

No Lines 3 Trench Width 36" Max Trench Bottom Depth _____ Gravel Depth _____

☐ New System ☐ Repair System Type: I, II, III, (IV), V, VI

System Description: Existing (LP conv.)

Repair System Description: LP PPBPS

Maintenance Agreement Required: ☐ Yes ☑ No not until repaired

☑ House/Mod. Home No. Bedrooms 2

☐ Mobile Home No. Bathrooms 2½

☐ Business No. Employees _____

☐ Other _____

☐ Slab ☐ Crawl Space ☑ Basement w/plumbing ☐ Basement wo/plumbing


Water Supply: ☑ Individual ☐ Community ☐ Public

Comments:

Comments: Existing system showing no sign of malfunction.

INITIAL SITE SKETCH

AS BUILT SKETCH

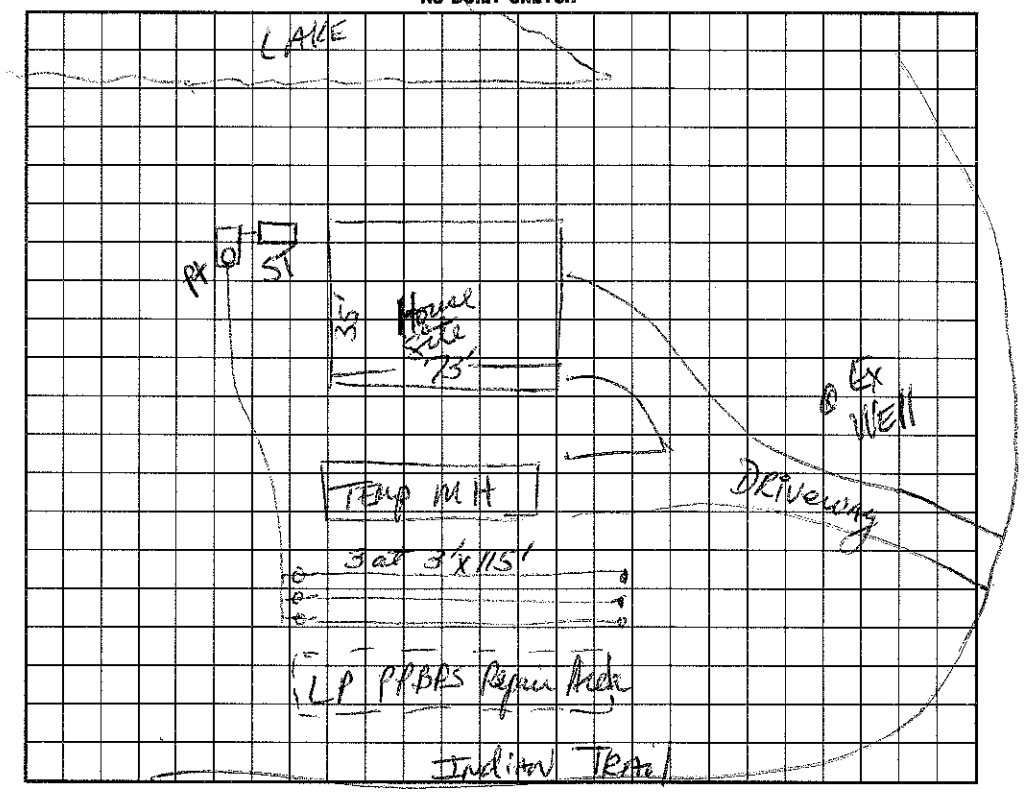

I understand that this permit can be suspended or revoked if any false information is supplied toward securing the permit/any unauthorized changes are made to the site/any unauthorized changes are made in the installation of the system. Improvement Permit is valid for 60 months from date of issuance.

Signed: _____

Improvement Permit by: _____ date _____

Existing System Inspection by: [signature] date 11/2/93

Installed by: _____

Certificate of Completion by: _____ date _____

Operation Permit by: _____ date _____

HEALTH DEPT. COPY: WHITE INSPECTION COPY (FINAL): GREEN OWNER COPY (FINAL): YELLOW INSPECTION COPY (INITIAL): PINK OWNER COPY (INITIAL): GOLD