IREDELL COUNTY HEALTH DEPARTMENT

STATESVILLE 704-878-5305 MOORESVILLE 704-664-5281

IMPROVEMENT PERMIT / AUTHORIZATION TO CONSTRUCT / OPERATION PERMIT / EXISTING SYSTEM INSPECTION

PERMIT# 080726 PIN# 4626 23 9097 DATE 6/15/99

OWNER OR CONTRACTOR Stuart Ahrens PHONE: Business Home 336-272-2824

ADDRESS 287 Indian Trail Rd. Mooresville, NC. 28117

LOCATION 1100, TR Chuckwood TR Indian Trail, .7 mile on (L)

SUBDIVISION CL+T BLOCK / SECTION 7 LOT 29 LOT AREA .82 AC SITE CLASS. DESIGN FLOW 360 L.T.A.R.

Septic Tank: EXISTING Gallons; STB Date

Pump Tank: Gallons; PT Date

Pump Make: Model Serial No.

Nitrification Field: No Fields EXISTING DRAINFIELD Trenches

No Lines Trench Width Max Trench Bottom Depth Gravel Depth

☐ New System ☐ Repair System Type: I (II) III, IV, V, VI

System Description: EXISTING BED

Repair System Description:

Maintenance Agreement Required: ☐ Yes ☒ No

☒ House/Mod. Home No. Bedrooms 3

☐ Mobile Home No. Bathrooms 2

☐ Business No. Employees

☐ Other


☐ Slab ☒ Crawl Space ☒ Basement w/plumbing ☐ Basement wo/plumbing

Water Supply: ☒ Individual ☐ Public ☐ Community


Comments:/Conditions: EXISTING SYSTEM - NO EVIDENCE OF PROBLEM NEW HOUSE LOCATED IN ORDER TO USE EX. SYSTEM.

Comments:/Conditions:

INITIAL SITE SKETCH ~~AS BUILT SKETCH~~

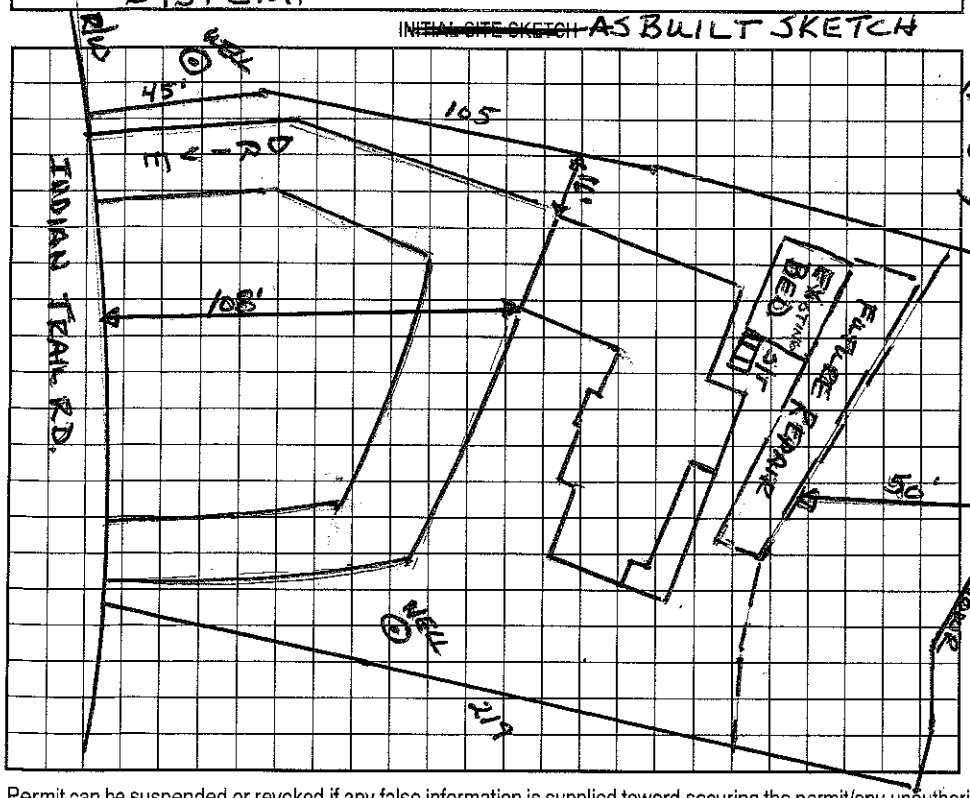

AS BUILT SKETCH

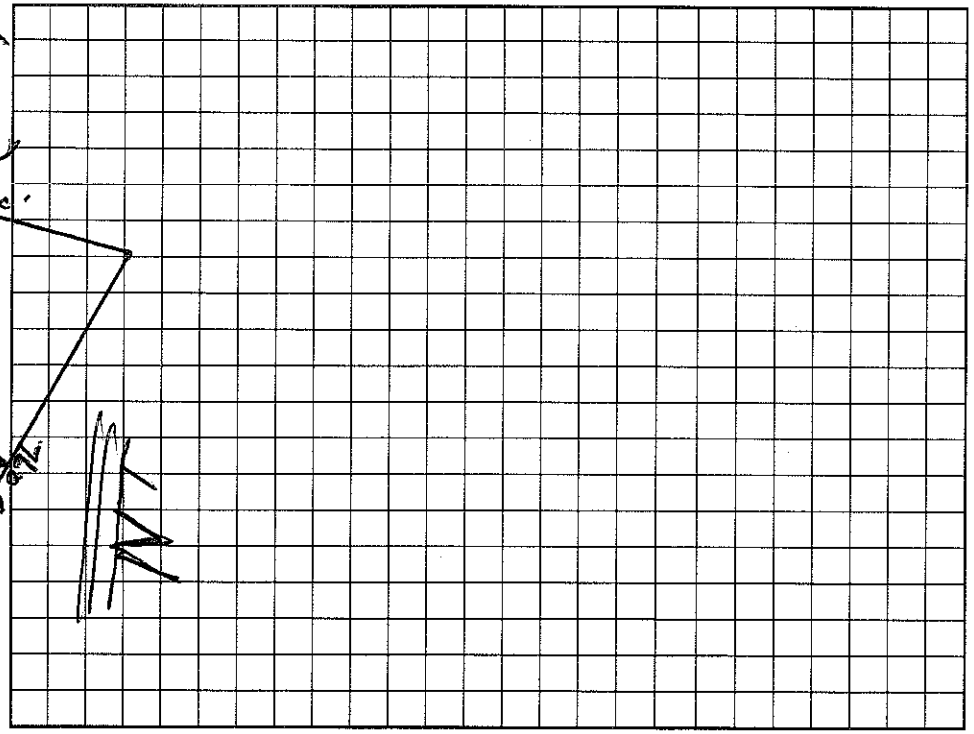

Permit can be suspended or revoked if any false information is supplied toward securing the permit/any unauthorized changes are made to the site/any unauthorized changes are made in the installation of the system. Improvement Permit with plat valid without expiration. Improvement Permit with site plan valid for sixty months. Authorization to Construct is valid for a period equal to that of Improvement Permit – not to exceed sixty months.

Signed: Willis Spears date 7-19-99

Improvement Permit by: date

Authorization to Construct by: date

Installed by:

Operation Permit by: Wesley Sparks RS. date 6/17/99

Existing System Inspection by: Wesley Sparks RS. date 6/17/99

HEALTH DEPT. COPY: WHITE OWNER COPY (FINAL): YELLOW OWNER COPY (INITIAL): PINK