IREDELL COUNTY HEALTH DEPARTMENT

Statesville Phone TR 3-7271 Mooresville Phone No. 664-5281

PERMIT TO INSTALL SEPTIC TANK

Permit No. 32 Permit Date 3-12 1973

Owner JAMES W. DAVIS Address Town + Country Ford CHARLOTTE, N.C.

Installed By Orbison Address MOORESVILLE, N.C.

Location of Property


SECTION 8 - LOT # 103

Tank		Capacity		Length of Lines		Fixtures	
Block	( )	1000	(✓)	225'	( )	No. of Baths	( )
Precast	(✓)	1250	( )	250'	( )	Dishwasher	( )
		1500	( )	Other		Garbage Grdr.	( )
		Other		EXTRA STONE FILLED		Other	

NOTIFY HEALTH DEPARTMENT AT LEAST EIGHT HOURS BEFORE TANK IS TO BE INSPECTED.

Final Inspection 3-12- 1973 Approved (✓) Disapproved ( )

Remarks

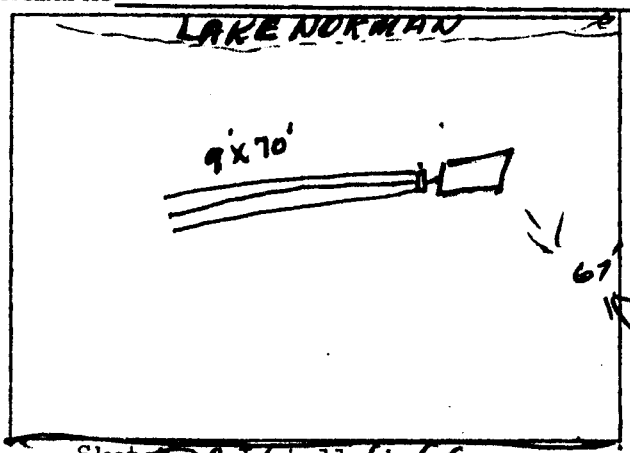

Sketch of Installation

TRAVEL TRAILER TO BE ON LOT FOR PRESENT TIME

Sanitarian

Rec # 1496