3:00.

IREDELL COUNTY HEALTH DEPARTMENT

STATESVILLE 704-878-5305 $125 MOORESVILLE 704-664-5281

Joe 980 722-0251

IMPROVEMENT PERMIT / AUTHORIZATION TO CONSTRUCT / OPERATION PERMIT / EXISTING SYSTEM INSPECTION

PERMIT# 10259520 PIN# 4626244357 Julie Jones 507-0119 DATE 10-2-2001

OWNER OR CONTRACTOR Jimmy Gutches PHONE: Business 662-0337 Home 987-8507.

ADDRESS 912 Lakeview Ave Apt. C Davidson, NC 28036

LOCATION Brawley School Rd. TR McKendree TL Kemp (1st Kemp) TL Cooley near end on right.

SUBDIVISION CLAY BLOCK / SECTION 8 LOT 163 LOT AREA SITE CLASS. PS DESIGN FLOW 360 gpd L.T.A.R. .3

Septic Tank: Existing Gallons; STB Date

Pump Tank: Gallons; PT Date

Pump Make: Model Serial No. 110

Nitrification Field: No Fields 1+Ex Square Feet 450+Ex Linear Feet ~~150~~+Ex

No Lines 2+Ex Trench Width 36 Max Trench Bottom Depth 36 Gravel Depth ~~12~~ N/A

☒ New System ☐ Repair System Type: ~~I~~ II III IV V VI

☒ Addition

System Description: Gravity Conventional

Repair System Description: Modified

Maintenance Agreement Required: ☐ Yes ☒ No

☒ House/Mod. Home ☐ Mobile Home ☐ Business ☐ Other

No. Bedrooms 3 No. Bathrooms 3½ No. Employees


☐ Slab ☒ Crawl Space ☐ Basement w/plumbing ☐ Basement wo/plumbing

Water Supply: ☒ Individual ☐ Public ☐ Community


Comments:/Conditions: Add to Existing Septic System 1-75' Drainline + 1-40' drainline + 1- 35' line = 150' Drainline added ~1:100 Distribution = Drop boxes

Comments:/Conditions: Upgrading from 2 Bedroom to 3 Bedroom. Must keep Septic System at least 50' from 760 line of lake. Keep new home 10' from Existing Septic

INITIAL SITE SKETCH

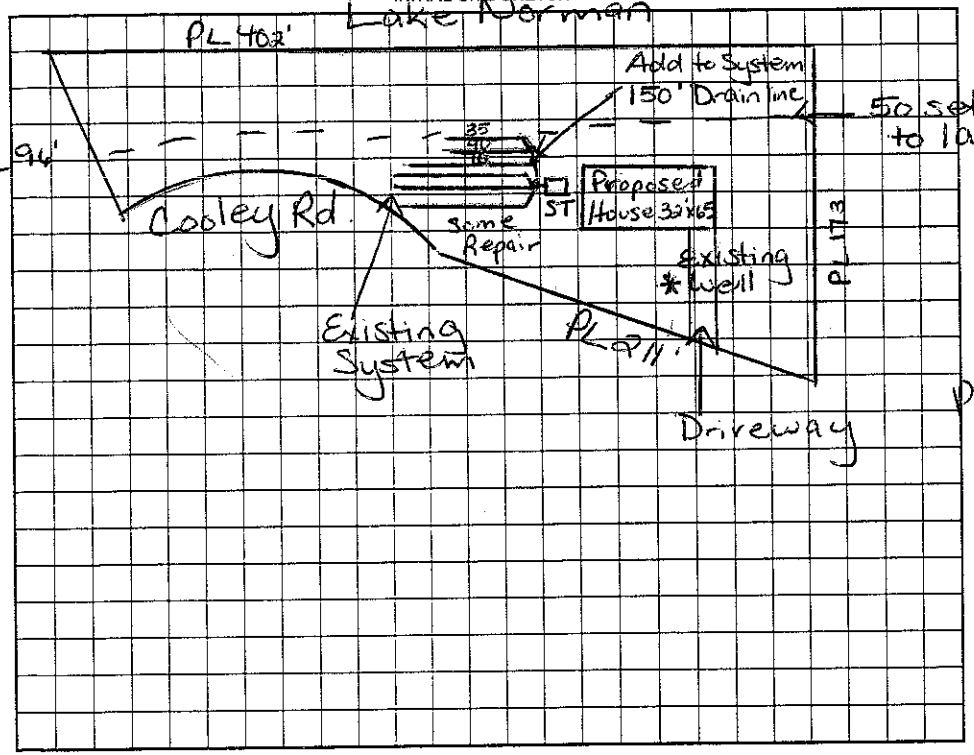

AS BUILT SKETCH

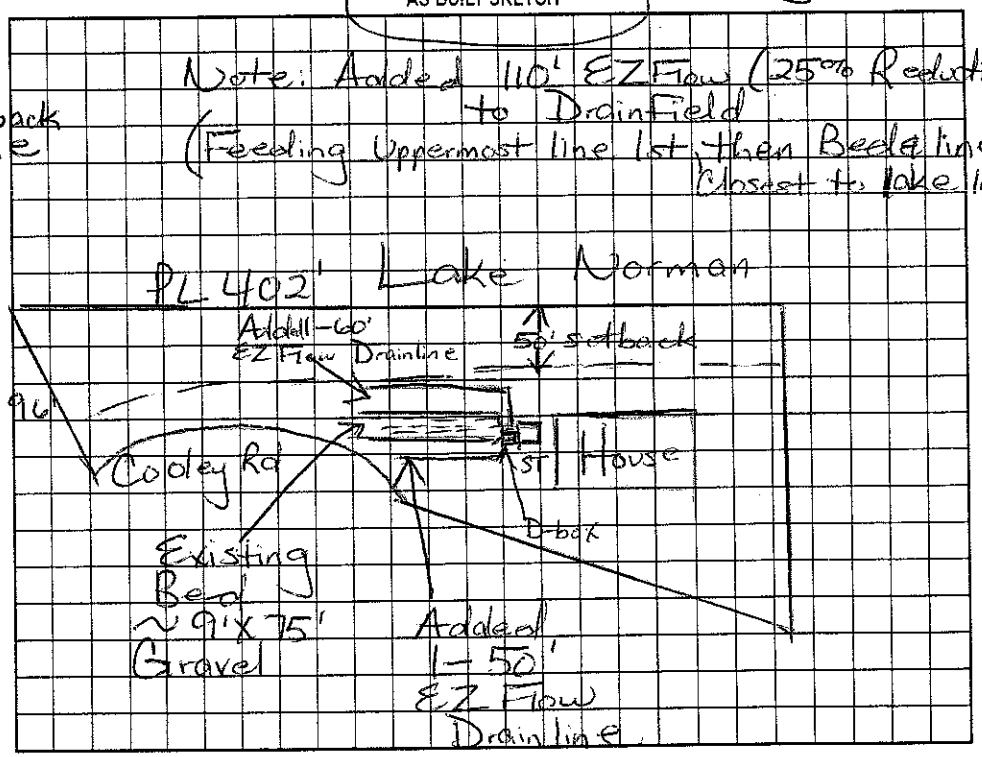

Permit can be suspended or revoked if any false information is supplied toward securing the permit/any unauthorized changes are made to the site/any unauthorized changes are made in the installation of the system. Improvement Permit with plat valid without expiration. Improvement Permit with site plan valid for sixty months. Authorization to Construct is valid for a period equal to that of Improvement Permit – not to exceed sixty months.

Signed: Julie K Jones date 10/2/01 Installed by: Joe Thompson R.S.

Improvement Permit by: Maria H. Dotson R.S. date 10/2/2001 Operation Permit by: Maria H. Dotson date 8/18/04

Authorization to Construct by: Maria H. Dotson R.S. date 10/2/2001 Existing System Inspection by: date

HEALTH DEPT. COPY: WHITE OWNER COPY (FINAL): YELLOW OWNER COPY (INITIAL): PINK