@ 3:30

IREDELL COUNTY HEALTH DEPARTMENT

STATESVILLE 704-878-5305 MOORESVILLE 704-664-5281

IMPROVEMENT PERMIT / AUTHORIZATION TO CONSTRUCT / OPERATION PERMIT / EXISTING SYSTEM INSPECTION

PERMIT# 070808 PIN# 4626248857 DATE 1/20/98

OWNER OR CONTRACTOR LANCE ARMSTRONG PHONE: Business Home 664-4492

ADDRESS 481 KEMP RD. MOORESVILLE NC 28115

LOCATION MCKENDREE RD - 1ST KEMP - TL COOLEY - ON RT

SUBDIVISION CLOT BLOCK / SECTION 8 LOT 107 LOT AREA .67AC SITE CLASS. PS DESIGN FLOW 360 L.T.A.R. .3 000/RT

Septic Tank: 1000 Gallons; STB 1012 Date 4/14/98

Pump Tank: 1000 Gallons; PT 17 Date 10/16/96

Pump Make: Model Serial No.

Nitrification Field: No Fields 1 Square Feet 400 Linear Feet 200

No Lines 4 @ 50' Trench Width 24" Max Trench Bottom Depth 36" Gravel Depth N/A

☑ New System ☐ Repair System Type: I II III IV, V, VI

System Description: PUMP PANEL

Repair System Description: SAME

Maintenance Agreement Required: ☐ Yes ☑ No

☑ House/Mod. Home No. Bedrooms 3

☐ Mobile Home No. Bathrooms 2

☐ Business No. Employees

☐ Other

☐ Slab ☑ Crawl Space ☐ Basement w/plumbing ☐ Basement wo/plumbing

Water Supply: ☑ Individual ☐ Public ☐ Community


Comments:/Conditions: WELL VARIANCE - SEE ATTACHED LETTER.

1"=40'

Comments:/Conditions:


½ TON TRUCK SITING ON DRAINFIELD AT TIME OF ELECTRICAL FINAL - 7/29/96 (C. [illegible]) MAY CAUSE PROBLEMS..

INITIAL SITE SKETCH

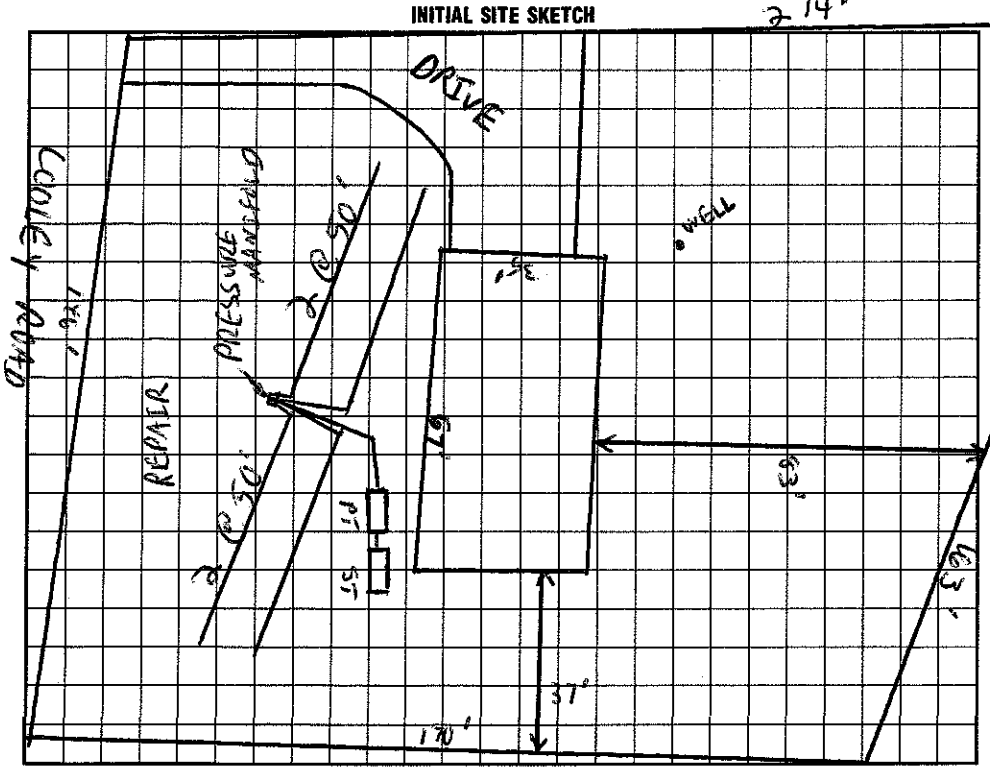

AS BUILT SKETCH

WAS TOLD THAT OTHER TRAFFIC OVER THE DRAINFIELD MAY OCCUR. BUILDER WAS ADVISED NOT TO DO SO. 7/29/98 C. [illegible]

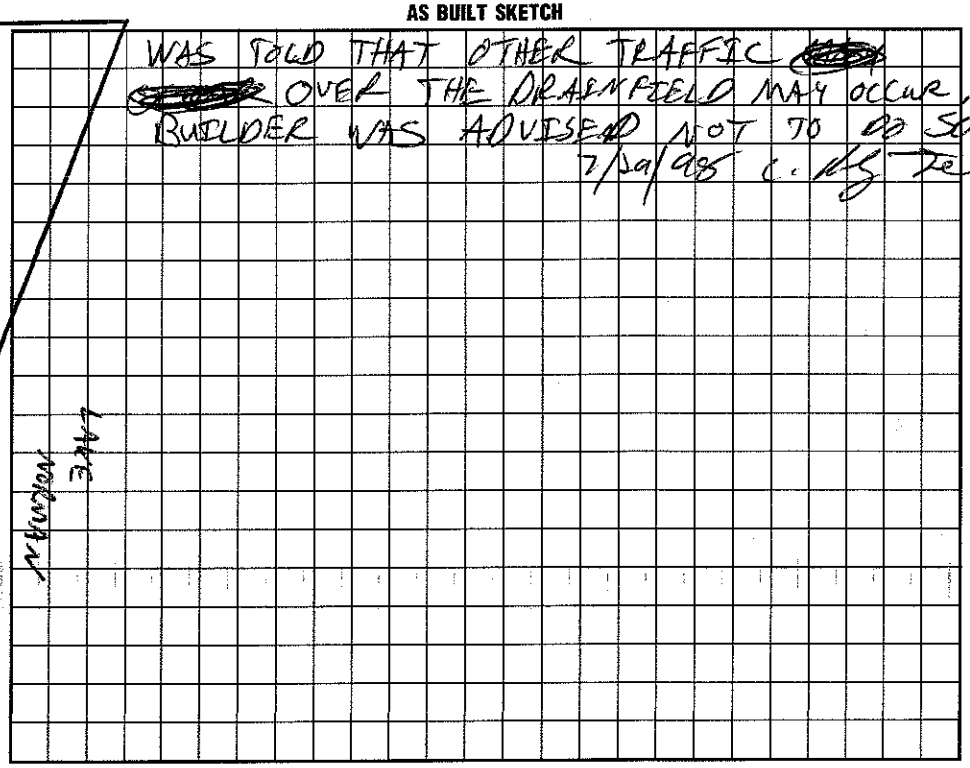

I understand that this permit can be suspended or revoked if any false information is supplied toward securing the permit/any unauthorized changes are made to the site/any unauthorized changes are made in the installation of the system. Improvement Permit with plat valid without expiration. Improvement Permit with site plan valid for sixty months. Authorization to Construct is valid for a period equal to that of Improvement Permit – not to exceed sixty months.

Signed: [signature] date

Improvement Permit by: C. [illegible] date 1/20/98

Authorization to Construct by: C. [illegible] date 1/20/98

Installed by: ABERNATHY

Operation Permit by: [illegible] RS date 7/29/98

Existing System Inspection by: date

HEALTH DEPT. COPY: WHITE INSPECTION COPY (FINAL): GREEN OWNER COPY (FINAL): YELLOW INSPECTION COPY (INITIAL): PINK OWNER COPY (INITIAL): GOLD