# IREDELL COUNTY HEALTH DEPARTMENT

STATESVILLE 704-878-5305 MOORESVILLE 704-664-5281

## IMPROVEMENT PERMIT / AUTHORIZATION TO CONSTRUCT / OPERATION PERMIT / EXISTING SYSTEM INSPECTION

PERMIT# 070808/13320 PIN# 4626 24 8857 DATE 1/18/06

OWNER OR APPLICANT LANCE ARMSTRONG PHONE: Business 704 877 8585 Home

ADDRESS 130 COOLEY RD MOORESVILLE, NC 28115

LOCATION BRAWLEY SCHOOL RD (R) MCKENDREE (L) KEMP (L) COOLEY (R) LOT 130 COOLEY RD

SUBDIVISION CL 87 BLOCK / SECTION 8 LOT 107 LOT AREA .67 ACRES SITE CLASS PS DESIGN FLOW 360 gpd L.T.A.R. .3

Septic Tank: 1000 Gallons; STB 1012 Date 4/4/98

Pump Tank: 1000 Gallons; PT 17 Date 10/18/96

Pump Make: Model Serial No.

Nitrification Field: No Fields 1 Square Feet eq 1200 Linear Feet 200

No Lines 4 Trench Width 24" Max Trench Bottom Depth 36" Gravel Depth NA ☐ Gravity ☒ Pressure

☐ New System ☐ Repair ☐ Expansion System Type: I II (III) IV V VI

System Description: PPBPS

Repair System Description: same

Maintenance Agreement Required: ☐ Yes ☒ No

☒ House/Mod. Home No. Bedrooms 3

☐ Mobile Home No. Persons

☐ Business No. Employees

☐ Other

Water Supply: ☒ Individual ☐ Public ☐ Community


☐ Slab ☒ Crawl Space ☐ Basement w/plumbing ☐ Basement wo/plumbing

Comments:/Conditions:

Comments:/Conditions: WELL VARIANCE. SYSTEM FUNCTIONING AS DESIGNED.

INITIAL SITE SKETCH

AS BUILT SKETCH

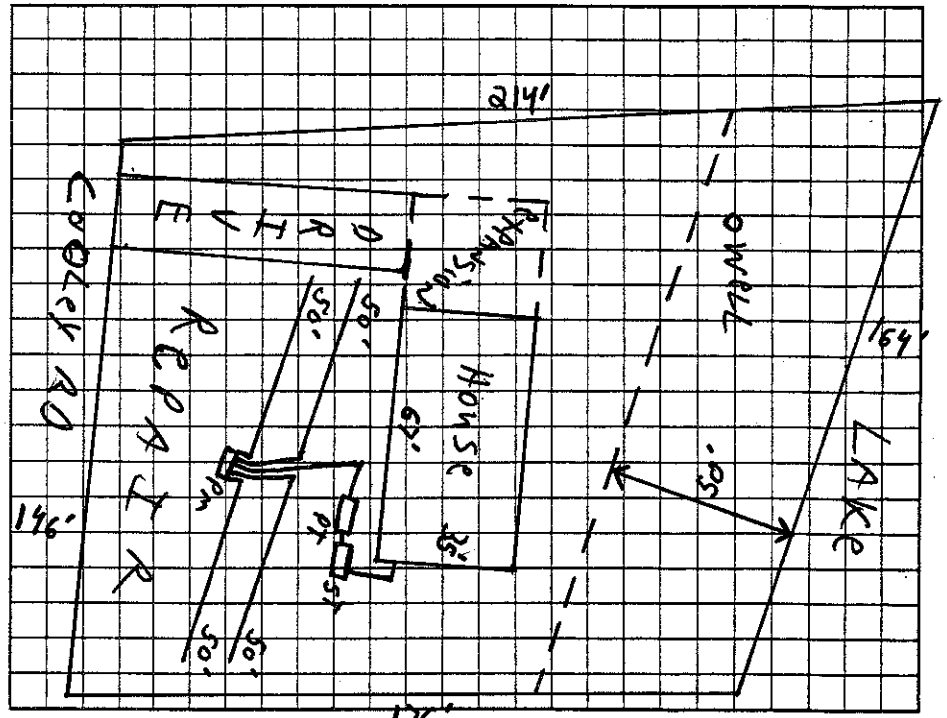


Permit can be suspended or revoked if any false information is supplied toward securing the permit/any unauthorized changes are made to the site/any unauthorized changes are made in the installation of the system. Improvement Permit with plat valid without expiration ☐ Improvement Permit with site plan valid for sixty months ☐ Authorization to Construct is valid for a period equal to that of Improvement Permit – not to exceed sixty months.

Signed: date Installed by:

Improvement Permit by: date Operation Permit by: date

Authorization to Construct by: date Existing System Inspection by: date 3/2/06

HEALTH DEPT. COPY: WHITE OWNER COPY (FINAL): YELLOW OWNER COPY (INITIAL): PINK