# IREDELL COUNTY HEALTH DEPARTMENT

STATESVILLE 704-878-5305 MOORESVILLE 704-664-5281

## IMPROVEMENT PERMIT / AUTHORIZATION TO CONSTRUCT / OPERATION PERMIT / EXISTING SYSTEM INSPECTION

11:00

PERMIT# 115275 PIN# 4626249525 DATE 9-11-06

OWNER OR CONTRACTOR Robert Robinson / Wood Bury PHONE: Business 704 523-3043 Home Steve Tuney 664-4400

ADDRESS 5616 Royal Troon Ct Charlotte, NC 28277

LOCATION Brawley School Rd TR McKendree TL Kemp Rd TL Cooley Rd on left #139

SUBDIVISION C & T BLOCK / SECTION 8 LOT 97 LOT AREA .81 Acre SITE CLASS PS DESIGN FLOW 480 L.T.A.R. .3

Septic Tank: 1000 Gallons; STB 794 Date 9-20-05

Pump Tank: 1000 Gallons; PT 27 Date 8-12-06

Pump Make: Goulds Model WE03[illegible]M Serial No.

Nitrification Field: No Fields 1 Square Feet 534 Linear Feet 267

No Lines 4@67' Trench Width Min. 24" Max Trench Bottom Depth 36" Gravel Depth N/A

☒ New System ☐ Repair System Type: I, II, III, IV, V, VI

System Description: Pump-LP- Panel Block

Repair System Description: Prior to 1983

Maintenance Agreement Required: ☒ Yes ☐ No

☒ House/Mod. Home No. Bedrooms 4

☐ Mobile Home No. Bathrooms

☐ Business No. Employees

☐ Other


☐ Slab ☐ Crawl Space ☒ Basement w/plumbing ☐ Basement wo/plumbing

Water Supply: ☒ Individual ☐ Public ☐ Community

Comments:/Conditions: Note: Owner using "Grinder pump" for Basement plumbing pump shall not discharge directly into Septic Tank. Use 4" Tine Former. At least 10ft from ST.

Comments:/Conditions: Must keep Septic System (tanks, drainlines & Supply line) 50' from all wells. *Supply line may be 25' from well if Constructed of ductile iron or equivalent. Checked tanks & lines

INITIAL SITE SKETCH Scale 1:50'

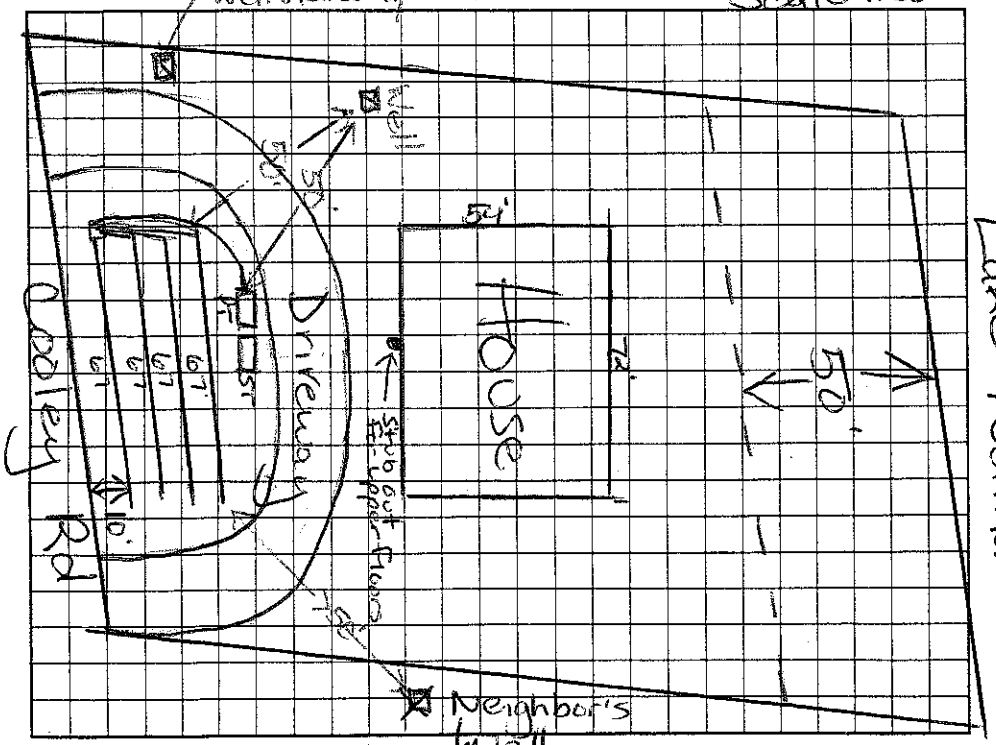


AS BUILT SKETCH

Drilled 3/16" holes
Pressure, elect & alarm 4/23/07 MJC

Permit can be suspended or revoked if any false information is supplied toward securing the permit/any unauthorized changes are made to the site/any unauthorized changes are made in the installation of the system. Improvement Permit with plat valid without expiration. Improvement Permit with site plan valid for sixty months. Authorization to Construct is valid for a period equal to that of Improvement Permit – not to exceed sixty months.

Signed: Steve Tuney date 9/11/06

Improvement Permit by: Maria H. Dotson RS. date 9/11/06

Authorization to Construct by: Maria H. Dotson RS date 9/11/06

Installed by: R & H date 4/24/07

Operation Permit by: Maria H. Dotson RS.

Existing System Inspection by: date

HEALTH DEPT. COPY: WHITE OWNER COPY (FINAL): YELLOW OWNER COPY (INITIAL): PINK