IREDELL COUNTY HEALTH DEPARTMENT

STATESVILLE 704-878-5305 MOORESVILLE 704-664-5281

IMPROVEMENT PERMIT / AUTHORIZATION TO CONSTRUCT / OPERATION PERMIT / EXISTING SYSTEM INSPECTION

PERMIT # 162478 PIN # 4626-25-4844 DATE 8-4-10

OWNER or APPLICANT LARRY WILCOX PHONE: Business 704-528-7960 Home: ERIC WARD

OWNER or APPLICANT ADDRESS 7220 PHARR MILL RD HARRISBURG NC 28075

LOCATION / DIRECTIONS DSR, TR MCKENDREE, TL KEMP, 4/3

SUBDIVISION CLET BLOCK / SECTION 8 LOT # 127 LOT AREA 1.8 AC DESIGN FLOW 360 GPD L.T.A.R.

Septic Tank EXISTING Gallons: STB Date

Pump Tank Gallons: P.T Date

Pump Make Model Serial #

Nitrification Field No Fields EXISTING No Lines Linear Feet

Trench Width Max. Trench Bottom Depth Gravel Depth

☐ New System ☐ Repair ☐ Expansion System Type I II III IV V VI

System Description: GRAVITY CONV. RED

Repair System Description: S 1983 PLAT

Maintenance Agreement Required ☐ YES ☒ NO

☒ GRAVITY ☐ PRESSURE

☒ Residence No. Bedrooms 3

☐ Business No. Persons

☐ Other No. Employees

☐ Slab ☒ Crawl Space


☐ Basement w/plumbing ☐ Basement w/o plumbing

Water Supply: ☒ Private ☐ Public ☐ Community


Comments / Conditions REMOVING EX HOME SETTING NEW HOME IN SAME PLACE

Comments / Conditions SYSTEM LOOKS GOOD @ TIME OF INSPECTION

INITIAL SITE SKETCH

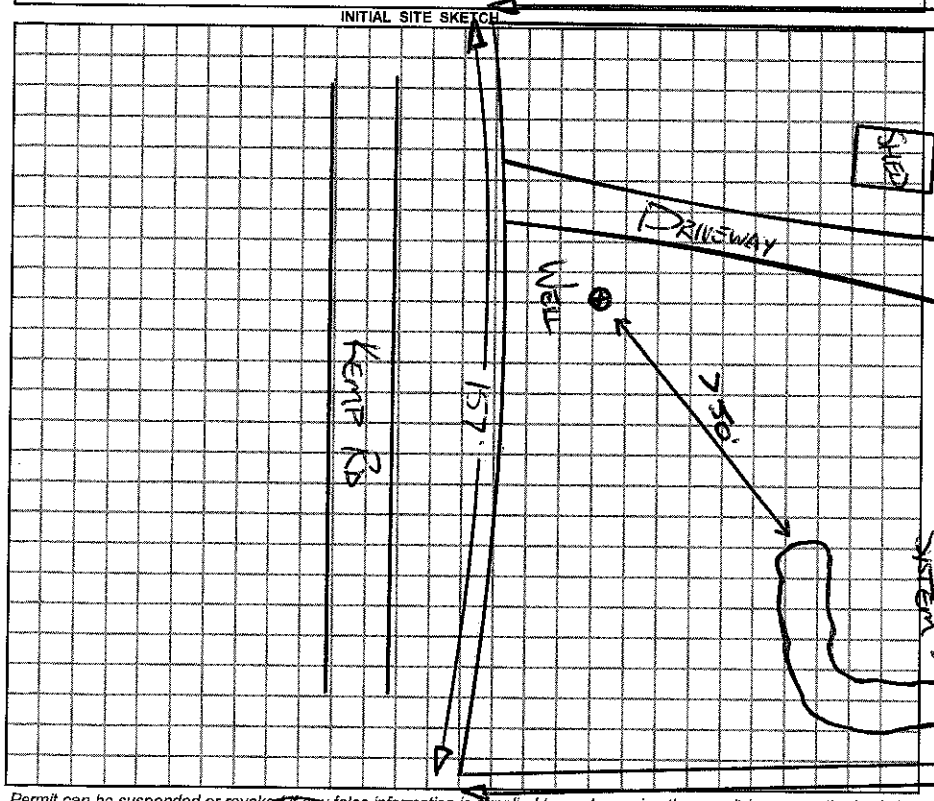

AS BUILT SKETCH

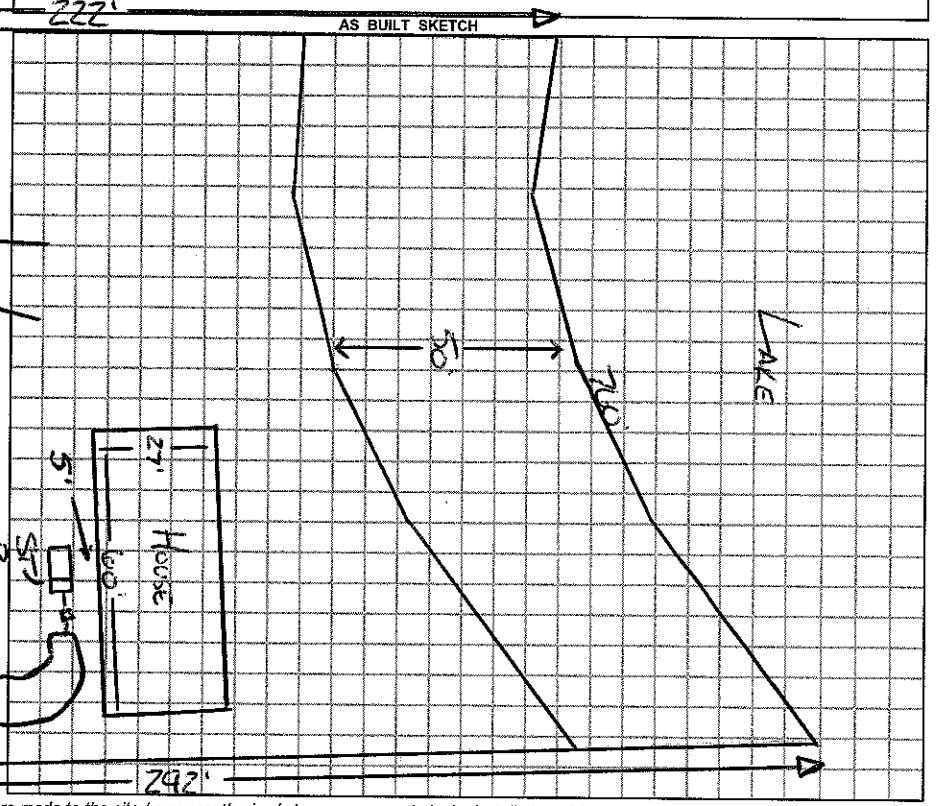

Permit can be suspended or revoked if any false information is supplied toward securing the permit / any unauthorized changes are made to the site / any unauthorized changes are made in the installation of the system.

☐ *IMPROVEMENT PERMIT w / plat valid without expiration* ☐ *IMPROVEMENT PERMIT w / site plan valid for 60 mos.* ☐ *AUTHORIZATION TO CONSTRUCT valid for period equal to IMPROVEMENT PERMIT-not to exceed 60 mo.*

Owner / Applicant Signature: Billy Kemp Date Oct 8-10

Improvement Permit by: Date

Authorization to Construct by: Date

YOU SHOULD CONTACT A LOCATOR SERVICE PRIOR TO ANY EXCAVATION.

Installed by:

Operation Permit by: Date:

Existing System Inspected by: B. A. Cook REHS Date: 8-4-10

WHITE COPY Environmental Health YELLOW COPY (Final) Owner / Applicant PINK COPY (Initial) Owner / Applicant