2:00

IREDELL COUNTY HEALTH DEPARTMENT

STATESVILLE 704-878-5305 MOORESVILLE 704-664-5281

IMPROVEMENT PERMIT / AUTHORIZATION TO CONSTRUCT / OPERATION PERMIT / EXISTING SYSTEM INSPECTION

PERMIT# 11873-2 PIN# ~~4626 38 4001. 354~~ 4626-26-0879 DATE 6/29/04

OWNER OR CONTRACTOR THE FARMS LLC / ES Johnson PHONE: Business 660-1185 Home

ADDRESS 2214 BRAWLEY SCHOOL RD - MOORESVILLE NC 28115

LOCATION BRAWLEY SCHOOL - TR McKENDREE - TL KEMP - TR ALDEN SPRINGS - TL BAYBERRY - ON LT

SUBDIVISION THE FARMS BLOCK / SECTION 3 LOT 354 LOT AREA .75AC SITE CLASS. PS DESIGN FLOW 480GPD L.T.A.R. .36-10/EF2

Septic Tank: 1600 Gallons; STB 338 Date 7-18-05
Pump Tank: 1000 Gallons; PT 283 Date 7-19-05
Pump Make: Myers Model ME-3-2150 Serial No.
Nitrification Field: No Fields 1 Square Feet 540 Linear Feet 270
No Lines 3@90 Trench Width 24" Max Trench Bottom Depth 36" Gravel Depth N/A

☑ New System ☐ Repair System Type: I, II, III, IV, V, VI
System Description: LP PANEL
Repair System Description: SAME
Maintenance Agreement Required: ☑ Yes ☐ No

☑ House/Mod. Home No. Bedrooms 4
☐ Mobile Home No. Bathrooms 4
☐ Business No. Employees
☐ Other


☐ Slab ☑ Crawl Space ☐ Basement w/plumbing ☐ Basement wo/plumbing

Water Supply: ☐ Individual ☐ Public ☐ Community

Comments:/Conditions:

Comments:/Conditions: Checked tanks & lines 8/24/05
Pressure, elect & alarm 9/19/05

1"=50' INITIAL SITE SKETCH

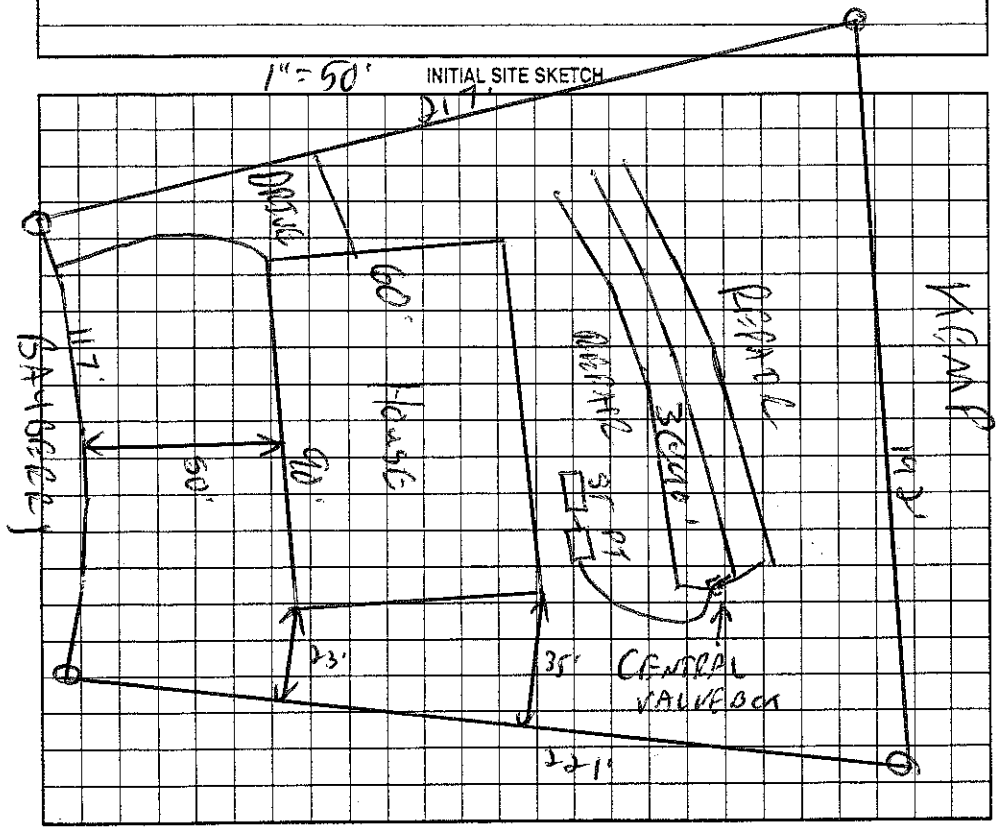

AS BUILT SKETCH

Installed as Drawn

Permit can be suspended or revoked if any false information is supplied toward securing the permit/any unauthorized changes are made to the site/any unauthorized changes are made in the installation of the system. Improvement Permit with plan valid without expiration. Improvement Permit with site plan valid for sixty months. Authorization to Construct is valid for a period equal to that of Improvement Permit – not to exceed sixty months.

Signed: [signature] date 7-12-04 Installed by: Willie Christenbury LS

Improvement Permit by: [signature] date 6/29/04 Operation Permit by: [signature] date 9/19/05

Authorization to Construct by: [signature] date 12/29/04 Existing System Inspection by: date

HEALTH DEPT. COPY: WHITE OWNER COPY (FINAL): YELLOW OWNER COPY (INITIAL): PINK