IREDELL COUNTY HEALTH DEPARTMENT

Statesville Office (704) 878-5305 Mooresville Office (704) 660-3625 PERMIT # 201033 ar

IMPROVEMENT PERMIT / AUTHORIZATION TO CONSTRUCT / OPERATION PERMIT / EXISTING SYSTEM

PIN # 4626-26-3144

APPLICANT: MARK RUMGARNER APPLICANT ADDRESS: 3325 MAYHEW FOREST LN MINT HILL

SITE ADDRESS: 105 LINDEN FALLS CT. - Mooresville PHONE: 704-650-5560 ALT. PHONE:

SITE DIRECTIONS: RSR, TR MCKENDREE, TL KEMP, TR ALDER SPRINGS, TL BAYBERRY, TL LINDEN FALLS

SUBDIVISION: THE FARMS SECTION: 3 LOT # 362 LOT AREA: .805 AC DESIGN FLOW: 480 L.T.A.R.: .3

Septic Tank	1500 (gal)	STB	390	Date	3/10	☒ New System ☐ Repair ☐ Expansion	System Type: I II (III) IV V VI	☒ Residence	No. Bedrooms 4
Pump Tank	(gal)	PT		Date		System Description:	25% REDUCTION	☐ Business	No. Persons 8
Pump Make		Model		Serial #		Repair System Description:	PANEL	☐ Other	No. Employees
# Nitrification Fields	1	# Lines	6	Linear Ft:	400'	Maintenance Agreement Required:	☐ YES ☒ NO	☐ Slab	☒ Crawl Space
Trench Width	36"	Max. Trench Bottom Depth	36"	Gravel Depth	—	☒ GRAVITY	☐ PRESSURE	Basement w/plumbing	☐ Basement w/o plumbing

Water Supply: ☐ Private ☐ Public ☒ Community


Comments / Conditions:

NEW HOUSE DESIGN SUBMITTED. SHOULD NOT INTERFERE WITH SEPTIC SYSTEM. 11/5/14 BC

INITIAL SITE SKETCH

SEE APPROVED PLAN FROM MICHAEL ATHANAS & ASSOCIATES BA

AS BUILT SKETCH

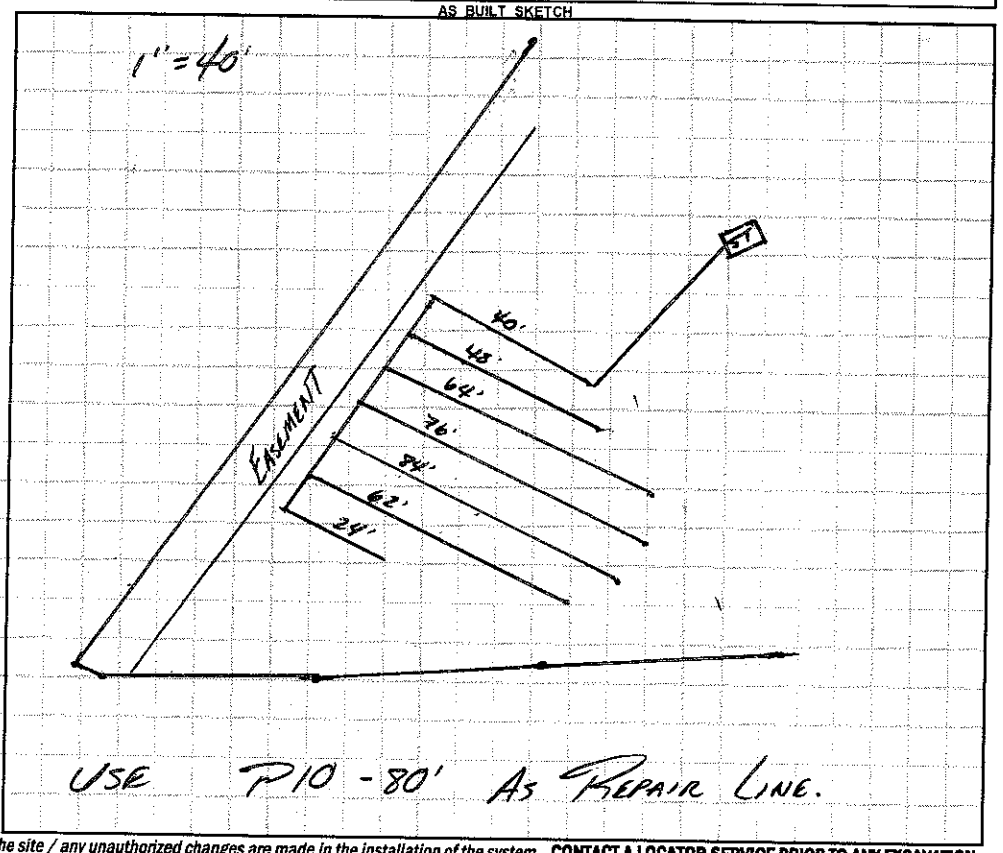

USE P10 - 80' AS REPAIR LINE.

Permit can be suspended or revoked if any false information is supplied toward securing the permit / any unauthorized changes are made to the site / any unauthorized changes are made in the installation of the system. **CONTACT A LOCATOR SERVICE PRIOR TO ANY EXCAVATION**

☐ **IMPROVEMENT PERMIT** *with plat valid without expiration.* ☒ **IMPROVEMENT PERMIT** *with site plan valid for 60 mos.* ☒ **AUTHORIZATION TO CONSTRUCT** *valid for period equal to IMPROVEMENT PERMIT--not to exceed 60 mo.*


Owner / Applicant Signature: Mark Rumgarner Date: 2-25-14 Installed by: Gunter's Grading

IMPROVEMENT PERMIT by: BA Date: 1-7-14 OPERATION PERMIT by:

AUTHORIZATION TO CONSTRUCT by: BA Date: 1-7-14 Existing System Inspected by: Date:

APPROVED FEB 10 2015

Health Dept. Copy - WHITE Applicant (Final Approval) - YELLOW Applicant (Conditional Approval) - PINK

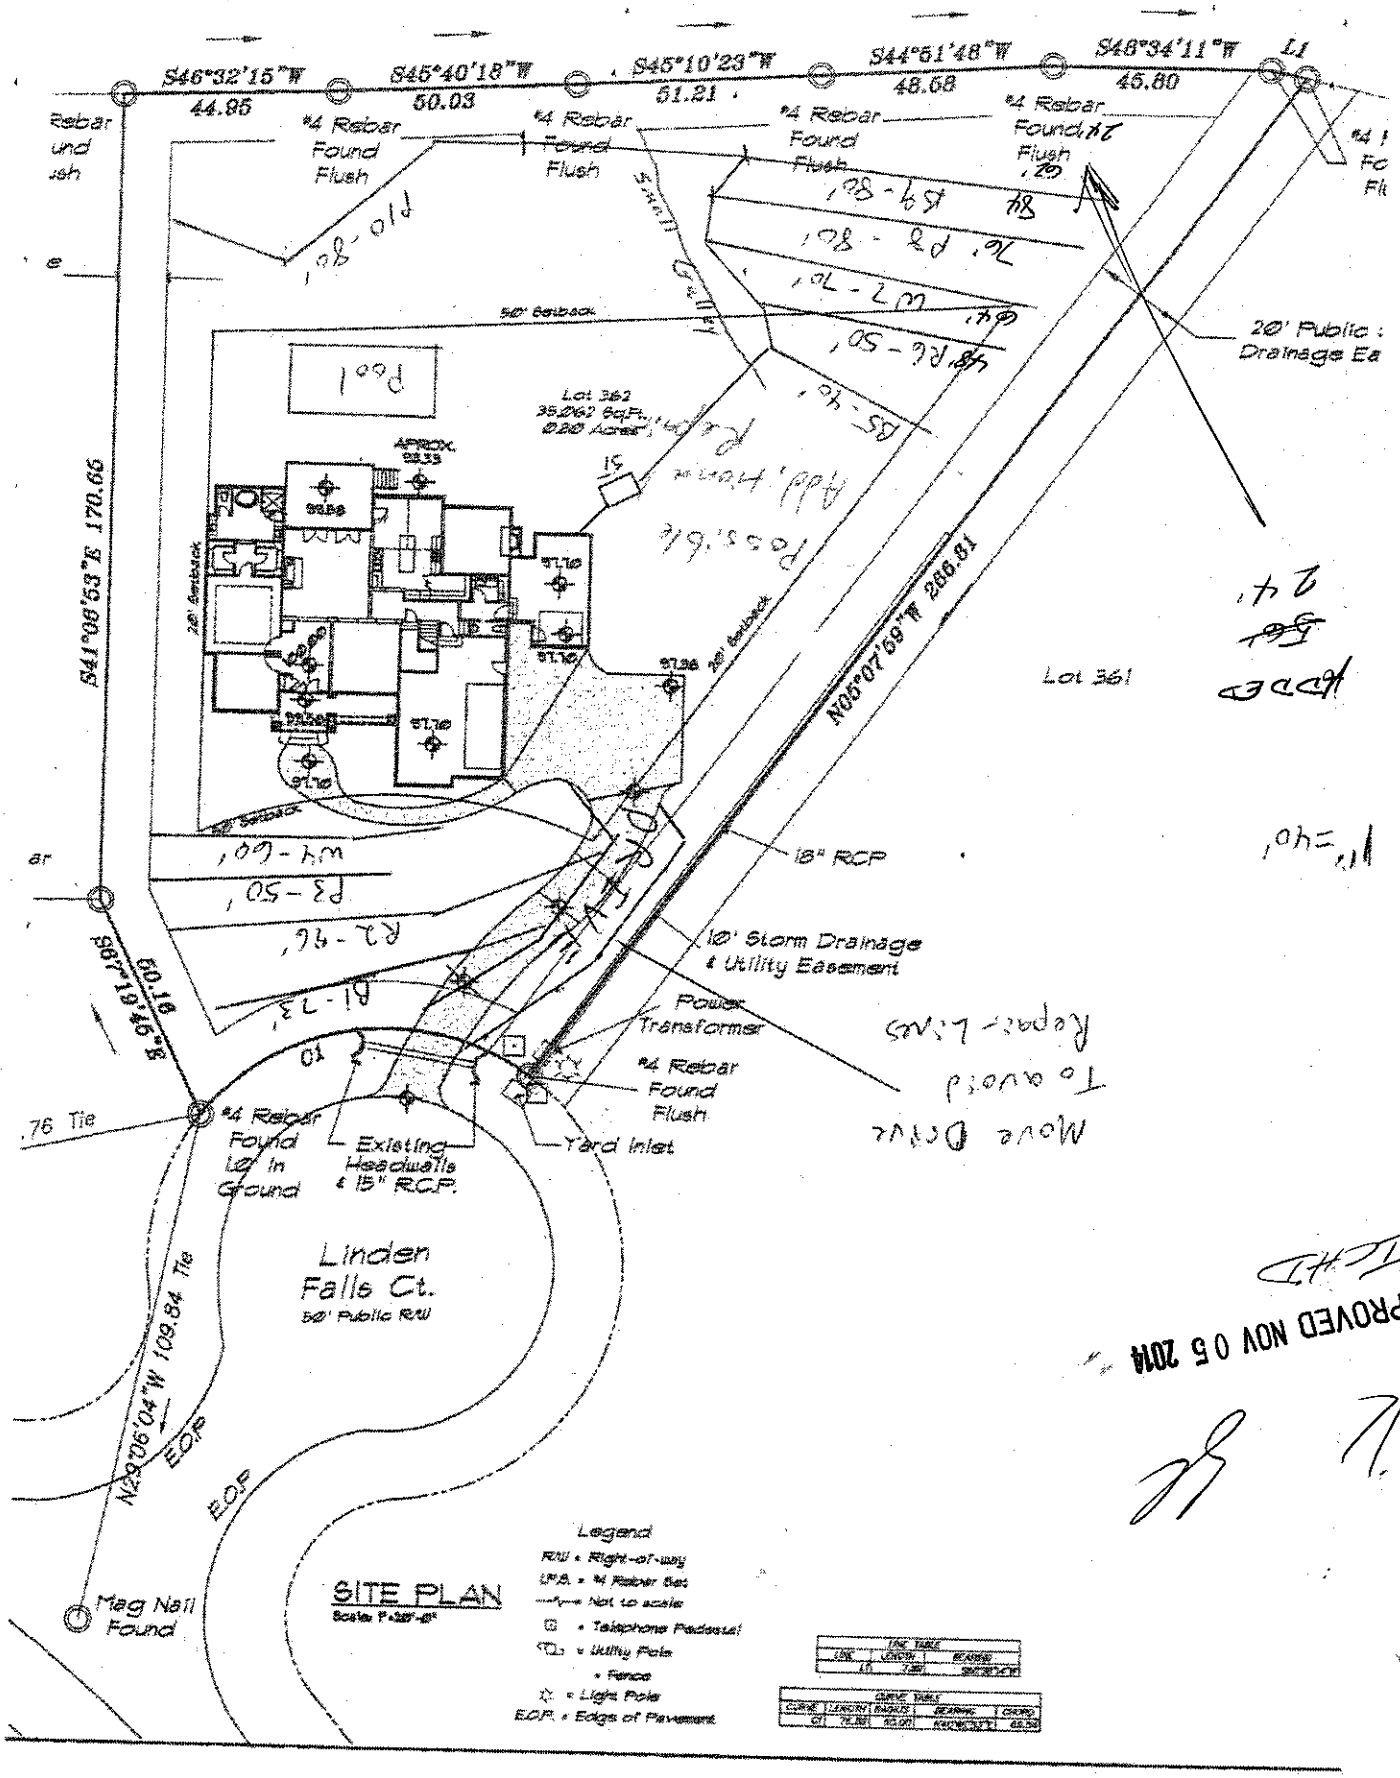
S46°32'15"W
44.86
S45°40'18"W
50.03
S45°10'23"W
51.21
S44°51'48"W
48.68
S48°34'11"W
45.80
L1
#4 Rebar Found Flush
#4 Rebar Found, 2' High
Flush
50' Setback
20' Public Drainage Ea
Lot 362
35,062 Sq.Ft.
Ø.80 Acres
APROX. 98.33
98.86
97.76
97.76
97.76
97.76
97.76
97.76
97.76
20' Setback
S41°08'53"E 170.66
N05°07'59"W 266.81
Lot 361
18" RCP
10' Storm Drainage & Utility Easement
Power Transformer
#4 Rebar Found Flush
Yard Inlet
#4 Rebar Found 1.0' In Ground
Existing Headwalls & 15" R.C.P.
S87°19'45"E 60.16
.76 Tie
Linden Falls Ct.
50' Public R/W
N29°06'04"W 109.84 Tie
E.O.P.
E.O.P.
Mag Nail Found
SITE PLAN
Scale: 1"=20'-0"
Legend
R/W = Right-of-way
I.P.S. = ¾ Rebar Set
= Not to scale
= Telephone Pedestal
= Utility Pole
= Fence
= Light Pole
E.O.P. = Edge of Pavement
LINE TABLE
CURVE TABLE
APPROVED NOV 05 2014