# IREDELL COUNTY HEALTH DEPARTMENT

STATESVILLE 704-878-5305 MOORESVILLE 704-664-5281

## IMPROVEMENT PERMIT / AUTHORIZATION TO CONSTRUCT / OPERATION PERMIT / EXISTING SYSTEM INSPECTION

PERMIT# 18752 PIN# ~~4626 38 4661.363~~ 4626264255.000 DATE 8/9/04

OWNER OR CONTRACTOR THE FARMS LLC / DS RUSHING CO. PHONE: Business 660-1185 Home

ADDRESS 2214 BRAWLEY SCHOOL RD MOORESVILLE NC 28117

LOCATION BRAWLEY SCHOOL - TR MCKENDREE, TL KEMP - TR ALDOR SPRINGS - TL BAYBERRY - ON LT - CORNER OF LINDEN FALLS

SUBDIVISION THE FARMS BLOCK / SECTION 3 LOT 363 LOT AREA .73AC SITE CLASS. RS DESIGN FLOW 480GPD L.T.A.R. .3600/FT2

Septic Tank: 1000 Gallons: STB 338 Date 8-6-06

Pump Tank: 1000 Gallons: PT 27 Date 8-6-06

Pump Make: Goulds Model WE0312M Serial No. S653311124

Nitrification Field: No Fields 1 Square Feet 1200 Linear Feet 400

No Lines 5@80' Trench Width 36" Max Trench Bottom Depth 36" Gravel Depth N/A

☑ New System ☐ Repair System Type: I, II, (III) IV, V, VI

System Description: PUMP 25% REDUCTION

Repair System Description: LP PANEL

Maintenance Agreement Required: ☐ Yes ☑ No

☑ House/Mod. Home No. Bedrooms 4

☐ Mobile Home No. Bathrooms 4

☐ Business No. Employees

☐ Other


☐ Slab ☑ Crawl Space ☐ Basement w/plumbing ☐ Basement wo/plumbing

Water Supply: ☐ Individual ☐ Public ☑ ~~Community~~


Comments/Conditions:

Comments/Conditions: 9/8/06 Checked tanks & lines

INITIAL SITE SKETCH 1"=50'

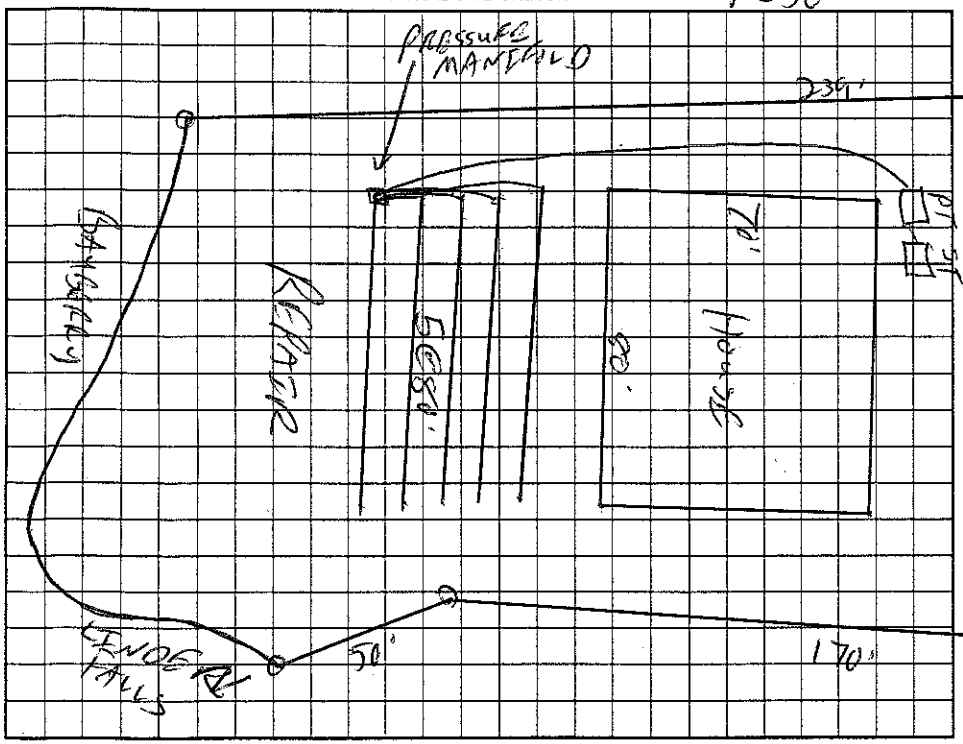


AS BUILT SKETCH

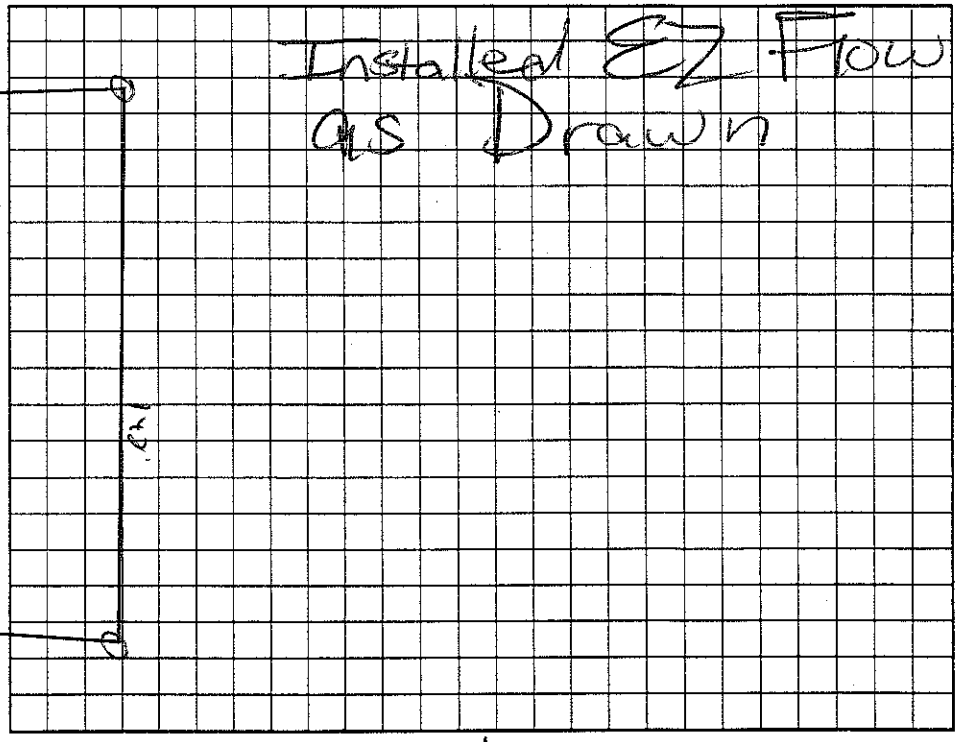


Permit can be suspended or revoked if any false information is supplied toward securing the permit/any unauthorized changes are made to the site/any unauthorized changes are made in the installation of the system. Improvement Permit with plat valid without expiration. Improvement Permit with site plan valid for sixty months. Authorization to Construct is valid for a period equal to that of Improvement Permit – not to exceed sixty months.

Signed: [signature] date 7-12-04 Installed by: R&H Dobson RS

Improvement Permit by: [signature] RS date 7/9/04 Operation Permit by: [signature] date 12/8/06

Authorization to Construct by: Wesley Sparks RS date 8/16/06 Existing System Inspection by: date

HEALTH DEPT. COPY: WHITE OWNER COPY (FINAL): YELLOW OWNER COPY (INITIAL): PINK