IREDELL COUNTY HEALTH DEPARTMENT

STATESVILLE 704-878-5305 MOORESVILLE 704-664-5281

1030 200

IMPROVEMENT PERMIT / AUTHORIZATION TO CONSTRUCT / OPERATION PERMIT / EXISTING SYSTEM INSPECTION

PERMIT# 118753 PIN# ~~4626-38-4001.367~~ 4626265349 DATE 6/29/04

OWNER OR CONTRACTOR THE FARMS LLC PHONE: Business 660-1185 Home

ADDRESS 2214 BRAWLEY SCHOOL - MOORESVILLE NC 28115

LOCATION BRAWLEY SCHOOL - TL MCKENDREE - TL KEMP - TR ALPER SPRINGS - TL BAYBERRY - ON LT 3165 Bayberry

SUBDIVISION THE FARMS BLOCK / SECTION 3 LOT 364 LOT AREA 1.73AC SITE CLASS. PS DESIGN FLOW 480GPD L.T.A.R. .3600/KFA

Septic Tank: 1000/1500 Gallons; STB 338 Date 10-6-16

Pump Tank: 1000 Gallons; PT 3 Date (12-4-13)

Pump Make: Goulds Model WE0312 Serial No.

Nitrification Field: No Fields 1 Square Feet 580 Linear Feet 290

No Lines 6 Trench Width 24" Max Trench Bottom Depth 36" Gravel Depth N/A

☑ New System ☐ Repair System Type: I, II, III, (IV), V, VI

System Description: LP Panel

Repair System Description: SAME

Maintenance Agreement Required: ☑ Yes ☐ No

☑ House/Mod. Home No. Bedrooms 4

☐ Mobile Home No. Bathrooms 4

☐ Business No. Employees

☐ Other

☐ Slab ☑ Crawl Space ☐ Basement w/plumbing ☐ Basement wo/plumbing


Water Supply: ☐ Individual ☐ Public ☑ ~~Community~~

Comments:/Conditions:


= ADM MEAS.
- TANK NEEDS TO SET FOR 24 HRS FROM 1/24/13
FULLED TO BE FILLED PROPERLY

Comments:/Conditions: DRIVE IN REPAIR - DRIVE WOULD NEED TO BE MOVED OUT OF REPAIR AREA - OK
2/28/13 Checked 2ft. pressure Elect & Alarm

INITIAL SITE SKETCH 1"=50'

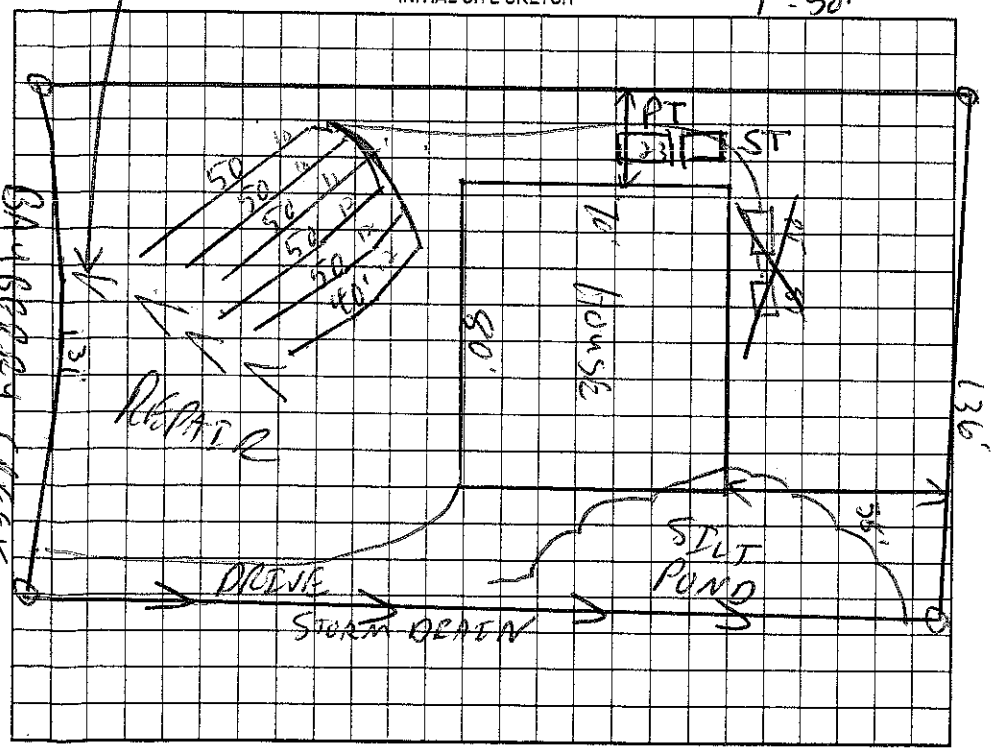

AS BUILT SKETCH

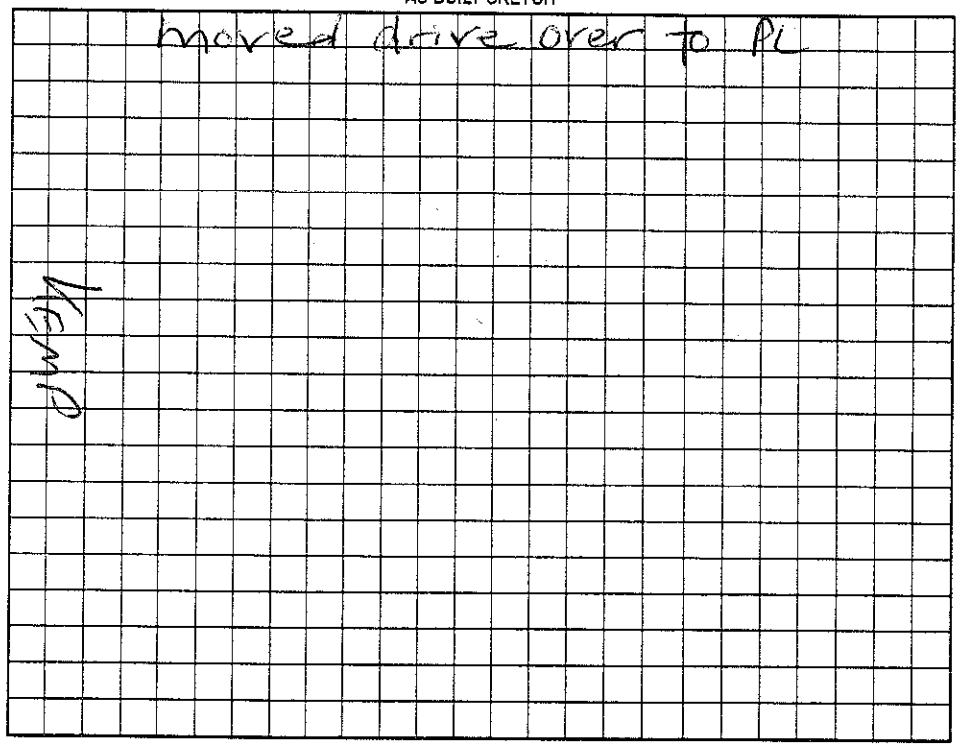

Permit can be suspended or revoked if any false information is supplied toward securing the permit/any unauthorized changes are made to the site/any unauthorized changes are made in the installation of the system. Improvement Permit with plat valid without expiration. Improvement Permit with site plan valid for sixty months. Authorization to Construct is valid for a period equal to that of Improvement Permit – not to exceed sixty months.

Signed: _____ date 7-12-04 Installed by: Stanley Septic

Improvement Permit by: _____ date 6/24/04 Operation Permit by: _____ RS date 2/28/13

Authorization to Construct by: _____ date 7-31-12 Existing System Inspection by: _____ date _____

HEALTH DEPT. COPY: WHITE OWNER COPY (FINAL): YELLOW OWNER COPY (INITIAL): PINK