IREDELL COUNTY HEALTH DEPARTMENT

STATESVILLE 704-878-5305 ~~MOORESVILLE 704-664-5281~~

IMPROVEMENT PERMIT / AUTHORIZATION TO CONSTRUCT / OPERATION PERMIT / EXISTING SYSTEM INSPECTION

PERMIT # _____ PIN # 4626-26-5803 DATE 5-19-10

OWNER or APPLICANT RONALD KORMANEK PHONE: Business 704-799-8955 Home: _____

OWNER or APPLICANT ADDRESS 552 BAYBERRY CREEK

LOCATION / DIRECTIONS BSR, TR MCKEENDRE, TL KEMP, TR ALDER SPRINGS, TL BAYBERRY CREEK

SUBDIVISION THE FARMS BLOCK / SECTION 3 LOT # 349 LOT AREA .95AC DESIGN FLOW 480GPD L.T.A.R. .25

Septic Tank EX. 1500 Gallons: STB 338 Date 9-8-05

Pump Tank EX. 1000 Gallons: PT 283 Date 9-26-05

Pump Make MYERS Model ME50 Serial # _____

Nitrification Field No Fields 1 No Lines 4 Linear Feet 320'

Trench Width 24" Max. Trench Bottom Depth 36" Gravel Depth —

☐ New System ☐ Repair ☐ Expansion System Type I II III (IV) V VI

System Description: EX LP- PANEL BLOCK

Repair System Description: SAME

Maintenance Agreement Required ☒ YES ☐ NO

☐ GRAVITY ☒ PRESSURE

☒ Residence No. Bedrooms 4 ☐ Water Supply

☐ Business No. Persons _____ ☐ Private

☐ Other No. Employees _____ ☐ Public


☐ Slab ☒ Crawl Space ☒ Community

☐ Basement w/plumbing ☐ Basement w/o plumbing


Comments / Conditions 1) POOL MUST BE MIN 15' FROM SEPTIC SYSTEM

Comments / Conditions

INITIAL SITE SKETCH

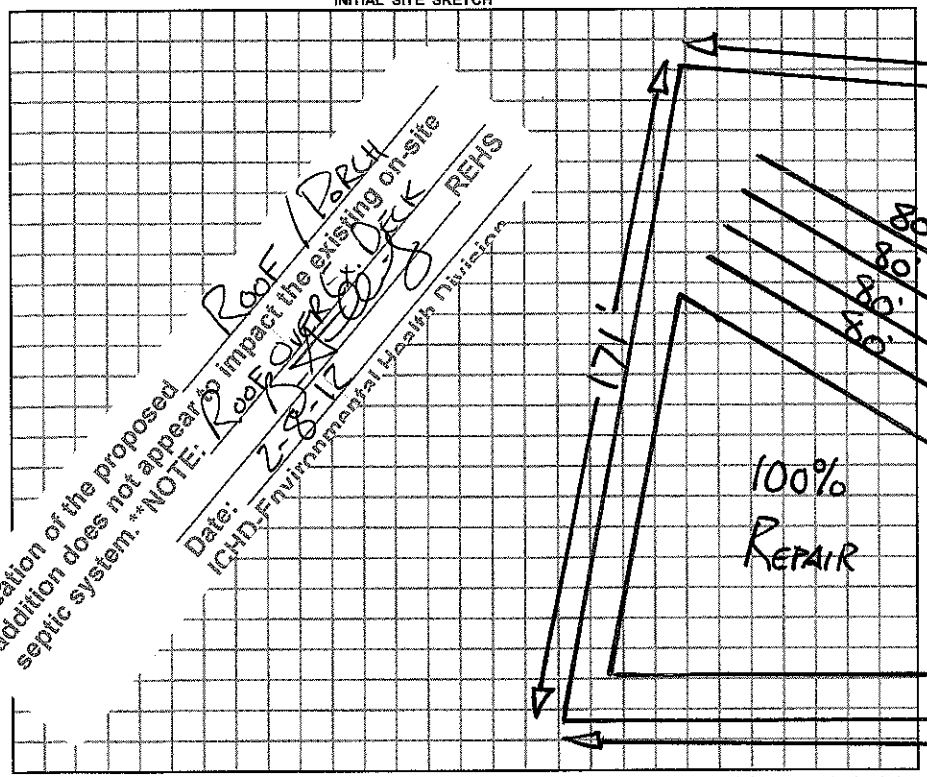

AS BUILT SKETCH

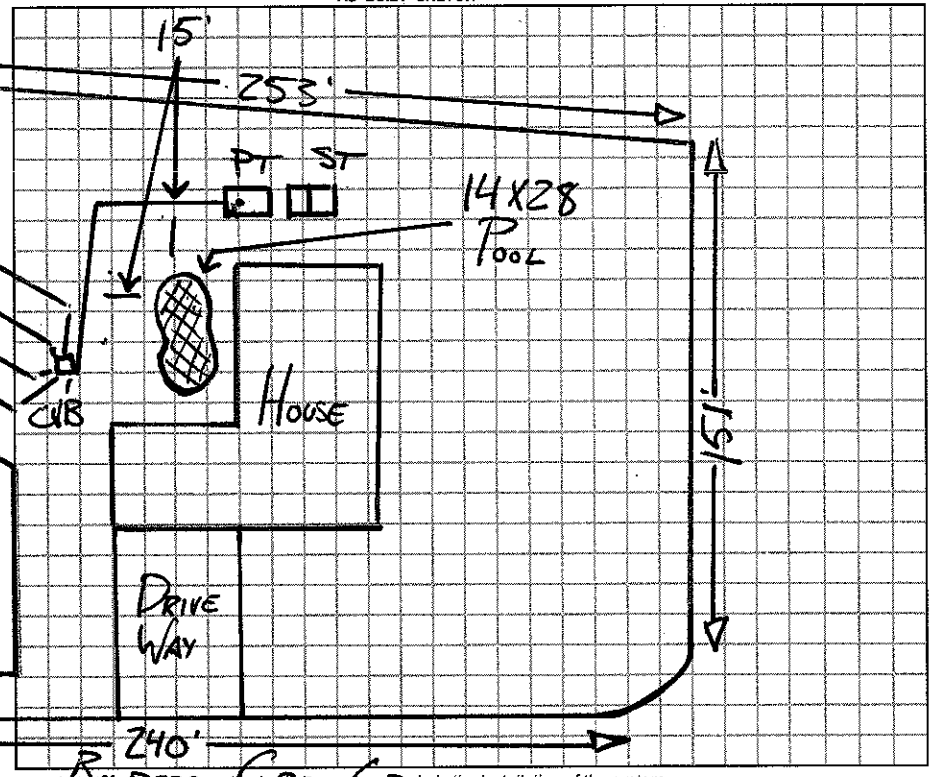

Permit can be suspended or revoked if any false information is supplied toward securing the permit / any unauthorized changes are made to any of the approved plans / any unauthorized changes are made in the installation of the system.

☐ *IMPROVEMENT PERMIT w / plat valid without expiration.* ☐ *IMPROVEMENT PERMIT w / site plan valid for 60 mos.* ☐ *AUTHORIZATION TO CONSTRUCT valid for period equal to IMPROVEMENT PERMIT-not to exceed 60 mo.*

Owner / Applicant Signature: _____ Date 5/27/10

Improvement Permit by: _____ Date _____

Authorization to Construct by: _____ Date _____

Installed by: _____

Operation Permit by: _____ Date: _____

Existing System Inspected by: _____ REHS Date: 5-19-10

YOU SHOULD CONTACT A LOCATOR SERVICE PRIOR TO ANY EXCAVATION.

WHITE COPY Environmental Health YELLOW COPY (Final) Owner / Applicant PINK COPY (Initial) Owner / Applicant