IREDELL COUNTY HEALTH DEPARTMENT

STATESVILLE 704-878-5305 MOORESVILLE 704-664-5281

2:00

IMPROVEMENT PERMIT / AUTHORIZATION TO CONSTRUCT / OPERATION PERMIT / EXISTING SYSTEM INSPECTION

PERMIT# 118713 PIN# ~~4626 38 9001. 349~~ 4626-26-5803 DATE 6/21/04

OWNER OR CONTRACTOR THE FARMS LLC / ES JOHNSON BUILDERS PHONE: Business 660-1185 Home

ADDRESS ~~PO~~ 214 BRAWLEY SCHOOL - MOORESVILLE NC 28115

LOCATION BRAWLEY SCHOOL - TR MCKENDREE - TL KEMP - TR ALDER SPRINGS - TL BAYBERRY - ON RT AT END B-4 CIRCLE

SUBDIVISION THE FARMS BLOCK / SECTION 3 LOT 349 LOT AREA .93Ac SITE CLASS PS DESIGN FLOW 480GPD L.T.A.R. .250PD/FT2

Septic Tank: ~~1000~~ 1500 Gallons; STB 338 Date 9/8/05
Pump Tank: 1000 Gallons; PT 283 Date 9/26/05
Pump Make: Myers Model ME50 Serial No.
Nitrification Field: No. Fields 1 Square Feet 640 Linear Feet 320
No. Lines 4@80' Trench Width 24" Max Trench Bottom Depth 36" Gravel Depth N/A

☑ New System ☐ Repair System Type: I, II, III, IV, V, VI
System Description: LP PANEL
Repair System Description: SAME
Maintenance Agreement Required: ☑ Yes ☐ No

☑ House/Mod. Home No. Bedrooms 4
☐ Mobile Home No. Bathrooms 4
☐ Business No. Employees
☐ Other


☐ Slab ☑ Crawl Space ☐ Basement w/plumbing ☐ Basement wo/plumbing

Water Supply: ☐ Individual ☐ Public ☑ Community

Comments:/Conditions:


Comments:/Conditions: 5/32" hole drilled, lines checked 11/1/05. Tank & lines set pressure @ 2FT

INITIAL SITE SKETCH 1"=50'

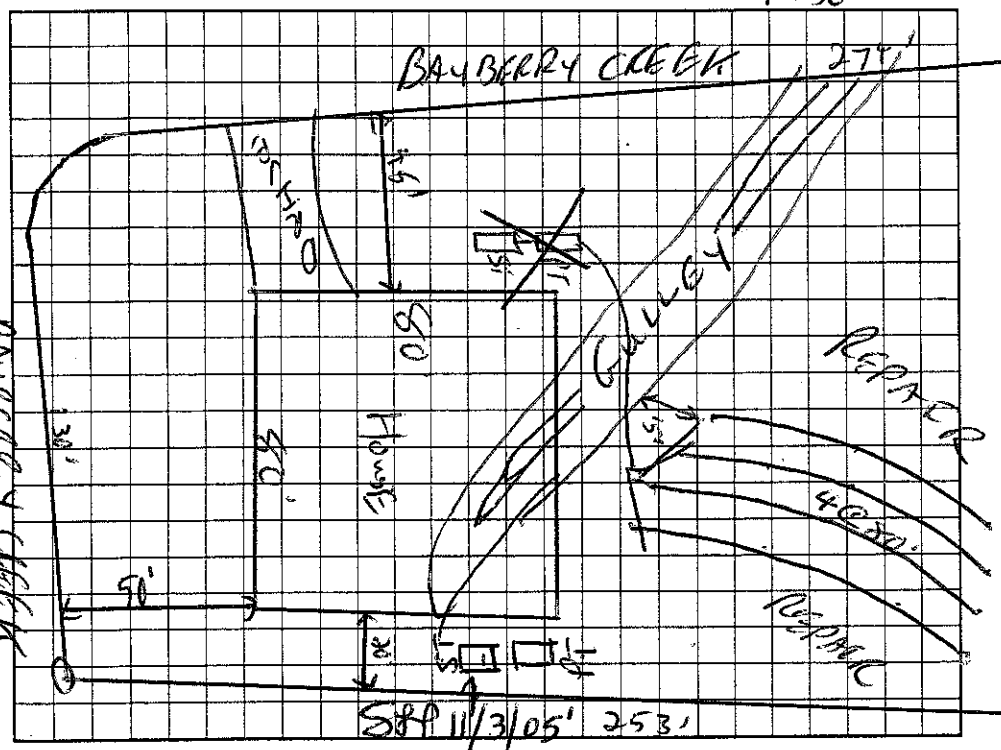

AS BUILT SKETCH

Installed as Drawn

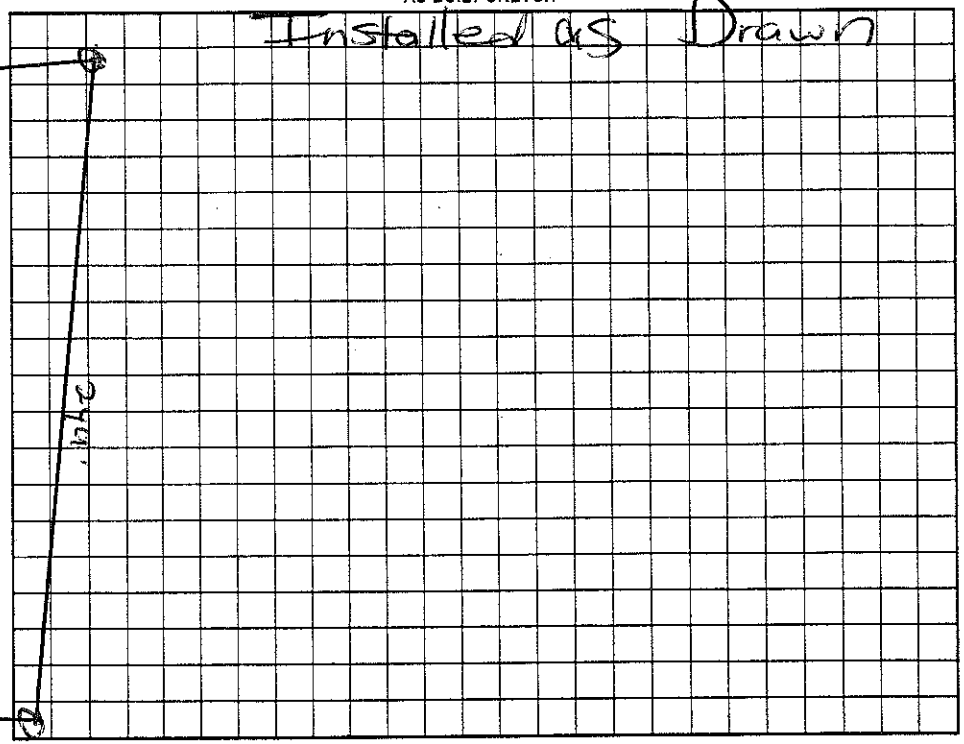

Permit can be suspended or revoked if any false information is supplied toward securing the permit/any unauthorized changes are made to the site/any unauthorized changes are made in the installation of the system. Improvement Permit with plat valid without expiration. Improvement Permit with site plan valid for sixty months. Authorization to Construct is valid for a period equal to that of Improvement Permit – not to exceed sixty months.

Signed: [signature] date 7-12-04 Installed by: Willie Christenbury

Improvement Permit by: [signature] RS date 6/21/04 Operation Permit by: [signature] date 11/17/06

Authorization to Construct by: [signature] RS date 6/8/05 Existing System Inspection by: date

HEALTH DEPT. COPY: WHITE OWNER COPY (FINAL): YELLOW OWNER COPY (INITIAL): PINK