IREDELL COUNTY HEALTH DEPARTMENT

STATESVILLE 704-878-5305 MOORESVILLE 704-664-5281

IMPROVEMENT PERMIT / AUTHORIZATION TO CONSTRUCT / OPERATION PERMIT / EXISTING SYSTEM INSPECTION

PERMIT # 1622116 PIN # 4626266044 DATE 10-28-2010

OWNER or APPLICANT CMR Builder Inc PHONE: Business 704 534-1499 Home: 704 896-0773

OWNER or APPLICANT ADDRESS 21121 Shearer Rd. Davidson, NC 28036

LOCATION / DIRECTIONS Brawley School Rd TR McKendree, TL Kemp Rd #401 (On Lake side)

SUBDIVISION C & T BLOCK / SECTION 8 LOT # 125 LOT AREA 1 DESIGN FLOW L.T.A.R.

Exist

Septic Tank 1250 Gallons: STB Date

Pump Tank Gallons: P T Date

Pump Make Model Serial #

Nitrification Field No Fields 1 No Lines 3 Linear Feet 240'

Trench Width 36 Max. Trench Bottom Depth Exist Gravel Depth 12"

☐ New System ☐ Repair ☐ Expansion System Type I II III IV V VI

System Description: Exist Gravity - Conventional Gravel

Repair System Description: Pump/Grav. 25-50% Reduct.

Maintenance Agreement Required ☐ YES ☐ NO

☐ GRAVITY ☐ PRESSURE

☒ Residence No. Bedrooms 3 ☐ Business No. Persons ☐ Other No. Employees ☐ Slab ☐ Crawl Space ☐ Basement w/plumbing ☐ Basement w/o plumbing

Water Supply ☒ Private ☐ Public ☐ Community

Comments / Conditions


Keep New home at least 25ft from well

Scale 1:40


Comments / Conditions

Existing Septic System appears to be Functioning Okay at time of inspection. Must keep New Home (including porches & decks) at least 5ft from Septic

INITIAL SITE SKETCH

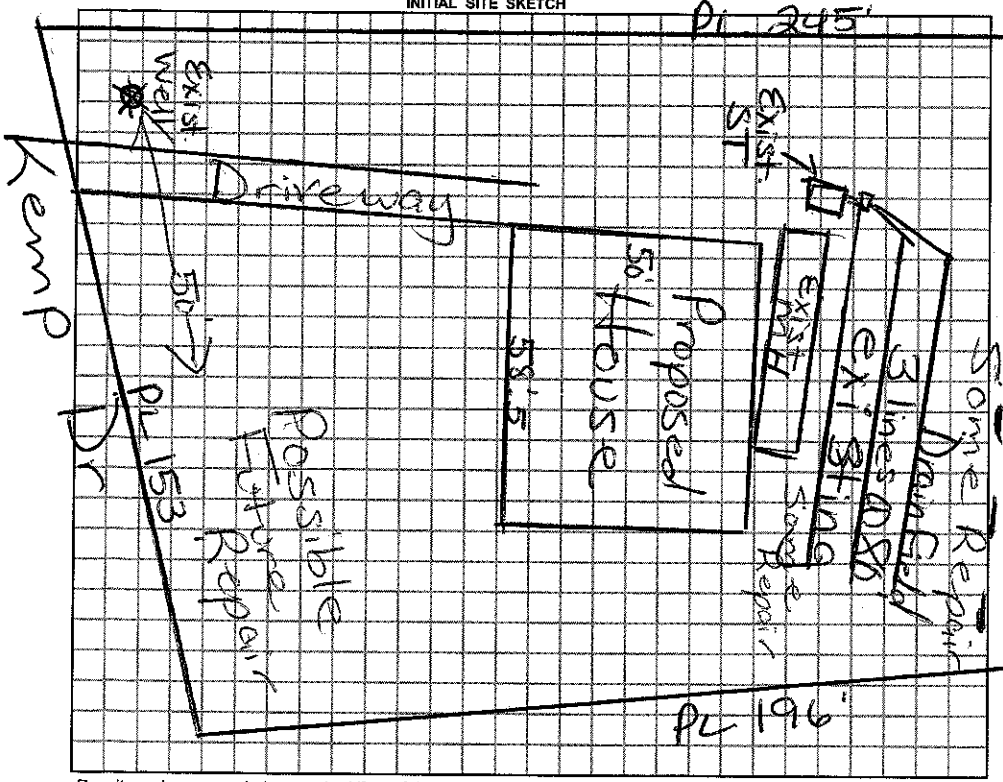

AS BUILT SKETCH

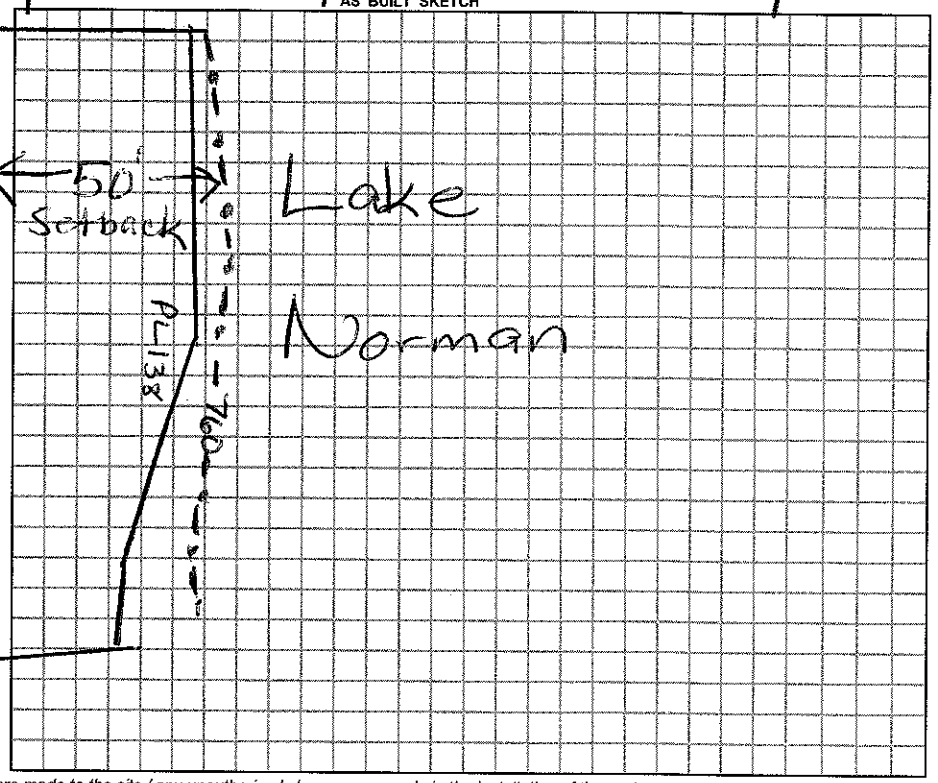

Permit can be suspended or revoked if any false information is supplied toward securing the permit / any unauthorized changes are made to the site / any unauthorized changes are made in the installation of the system.

☐ *IMPROVEMENT PERMIT w / plat valid without expiration.* ☐ *IMPROVEMENT PERMIT w / site plan valid for 60 mos.* ☐ *AUTHORIZATION TO CONSTRUCT valid for period equal to IMPROVEMENT PERMIT-not to exceed 60 mo.*

Owner / Applicant Signature: Date

Improvement Permit by: Date

Authorzation to Construct by: Date

YOU SHOULD CONTACT A LOCATOR SERVICE PRIOR TO ANY EXCAVATION.

Installed by: Richard Abernathy on 10-31-83

Operation Permit by: Date:

Existing System Inspected by: Date: 10/29/2010

WHITE COPY Environmental Health YELLOW COPY (Final) Owner / Applicant PINK COPY (Initial) Owner / Applicant