IREDELL COUNTY HEALTH DEPARTMENT

STATESVILLE 704-878-5305 MOORESVILLE 704-664-5281

1:30

IMPROVEMENT PERMIT / AUTHORIZATION TO CONSTRUCT / OPERATION PERMIT / EXISTING SYSTEM INSPECTIO

PERMIT# 118754 PIN# ~~4626 38 4001. 365~~ 4626266428.000 DATE 6/24/04

OWNER OR CONTRACTOR THE FARMS LLC / Robinette Bldrs PHONE: Business 660-1185 Home

ADDRESS 2214 BRAWLEY SCHOOL Rd - MOORESVILLE NC 28115

LOCATION BRAWLEY SCHOOL - TR MCKENDREE - TL KEMP - TR ALDER SPRINGS - TL BAYBERRY - ON LT

SUBDIVISION THE FARMS BLOCK / SECTION 3 LOT 365 LOT AREA .77AC SITE CLASS. PS DESIGN FLOW 480 GPD L.T.A.R. .30 PD/KFT²

Septic Tank: 1000 Gallons; STB 10-10-05 Date 335

Pump Tank: 1000 Gallons; PT 10-7-05 Date 253

Pump Make: GOULDS Model WE0312MV Serial No.

Nitrification Field: No Fields 1 Square Feet 1200 Linear Feet 400

No Lines 4@100' Trench Width 36" Max Trench Bottom Depth 36" Gravel Depth N/A

☑ New System ☐ Repair System Type: I, II, III, IV, V, VI

System Description: LP PUMP 25% REDUCTION

Repair System Description: LP PANEL

Maintenance Agreement Required: ☐ Yes ☑ No

☐ House/Mod. Home No. Bedrooms 4

☐ Mobile Home No. Bathrooms 4

☐ Business No. Employees

☐ Other

☐ Slab ☑ Crawl Space ☑ Basement w/plumbing ☐ Basement wo/plumbing

Water Supply: ☐ Individual ☐ Public ☑ Community

Comments:/Conditions:

11/7/05

Comments:/Conditions: PARTIAL POLY-LOK FITTAG


25 panels per ditch

Checked uppermost line, installed Quick 4


pressure checked 4-7-06 retested 4-10-06

after line broke & repaired

INITIAL SITE SKETCH 1"=50'

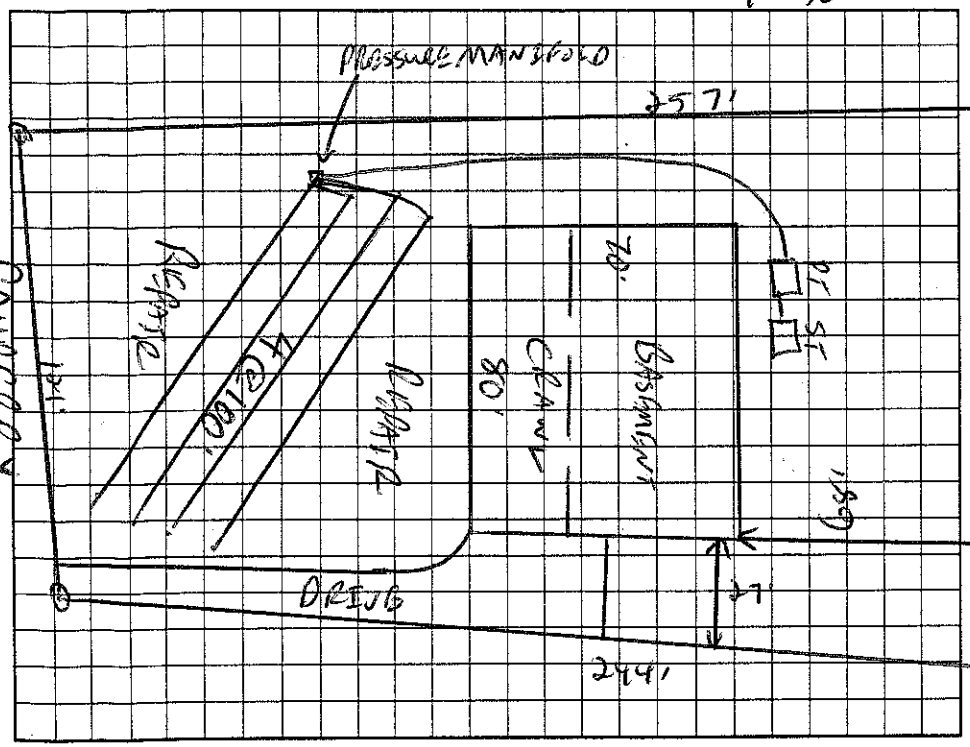

AS BUILT SKETCH

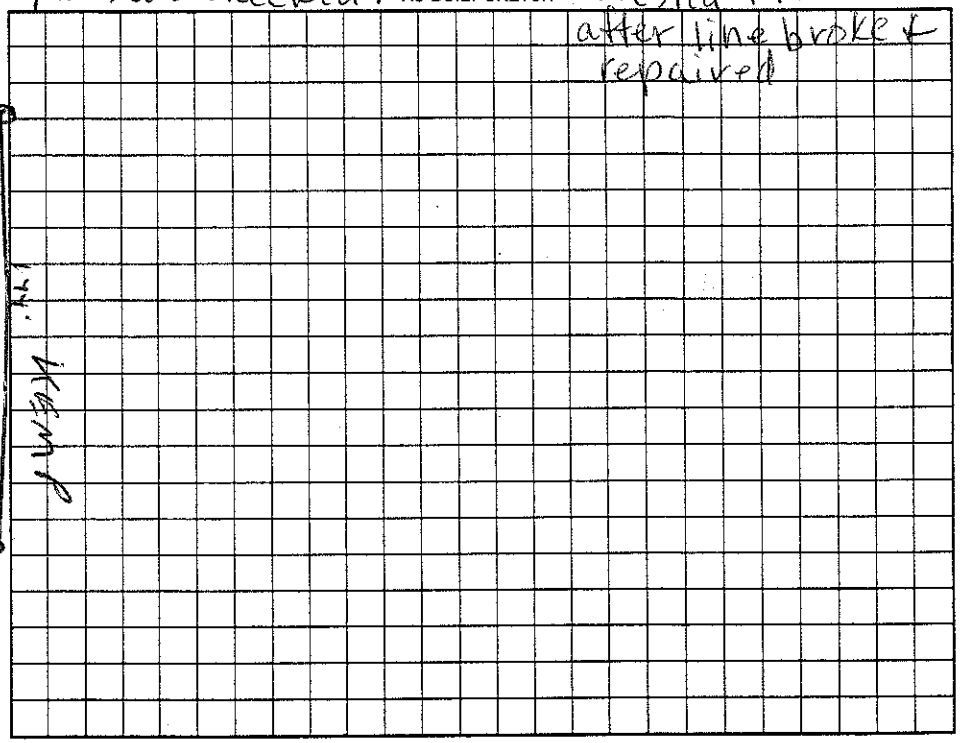

Permit can be ~~suspended~~ or revoked if any false information is supplied toward securing the permit/any unauthorized changes are made to the site/any unauthorized changes are made in the installation of the system. Improvement Permit with plat valid without expiration. Improvement Permit with site plan valid for sixty months. Authorization to Construct is valid for a period equal to that of Improvement Permit - not to exceed sixty months.

Signed: [signature] date 7-12-04 Installed by: Gerald Tucker

Improvement Permit by: [signature] RS date 6/24/04 Operation Permit by: Judy Merrills date 4-10-06

Authorization to Construct by: [signature] RS date 1/26/05 Existing System Inspection by: date

HEALTH DEPT. COPY: WHITE OWNER COPY (FINAL): YELLOW OWNER COPY (INITIAL): PINK