IREDELL COUNTY HEALTH DEPARTMENT

STATESVILLE 704-878-5305 MOORESVILLE 704-664-5281

IMPROVEMENT PERMIT / AUTHORIZATION TO CONSTRUCT / OPERATION PERMIT / EXISTING SYSTEM INSPECTION

11:30

PERMIT# 118755 PIN# ~~4626 38 4001.366~~ 4626 26 6598 Jim's Mobile DATE 6/24/04

OWNER OR CONTRACTOR THE FARMS LLC / Lakeshore Hobbies PHONE: Business 660-1155 Home 704-746-7515

ADDRESS 2214 BRAWLEY SCHOOL - MOORESVILLE NC 28115

LOCATION BRAWLEY SCHOOL - TR McKENDREE - TL KEMP - TR ALDER SPRINGS - TL BAYBERRY - ON LT

SUBDIVISION THE FARMS BLOCK / SECTION 3 LOT 366 LOT AREA .76Ac SITE CLASS PS DESIGN FLOW 480GPD L.T.A.R. .36GPD/FT²

Septic Tank: 1000 Gallons; STB 444 Date 6-24-12

Pump Tank: 4000 Gallons; PT 283 Date 5-28-11

Pump Make: Gaulds Model WE0312V Serial No.

Nitrification Field: No Fields 1 Square Feet 1200 Linear Feet 400

No Lines 4@100' Trench Width 36" Max Trench Bottom Depth 36" Gravel Depth N/A

☑ New System ☐ Repair System Type: I, II, III, IV, V, VI

System Description: PUMP 25% REDUCTION

Repair System Description: UP PANEL

Maintenance Agreement Required: ☐ Yes ☐ No

☑ House/Mod. Home No. Bedrooms 4

☐ Mobile Home No. Bathrooms 4

☐ Business No. Employees

☐ Other


☐ Slab ☑ Crawl Space ☐ Basement w/plumbing ☐ Basement wo/plumbing

Water Supply: ☐ Individual ☐ Public ☑ Community


Comments:/Conditions: ~~X~~ Installed Initial Drainfield in 5 lines (80ft) instead of 4 lines (100ft) Found some extra repair room behind house. Set in line filter in PT Set 2ft pressure manifold

Comments:/Conditions: ~~FACTORY BASEMENT~~ All crawl space New ST/PT location on side of house 8/6/12 Checked tanks 8/8/12 Checked Drainlines Quick 4

INITIAL SITE SKETCH 1"=50'

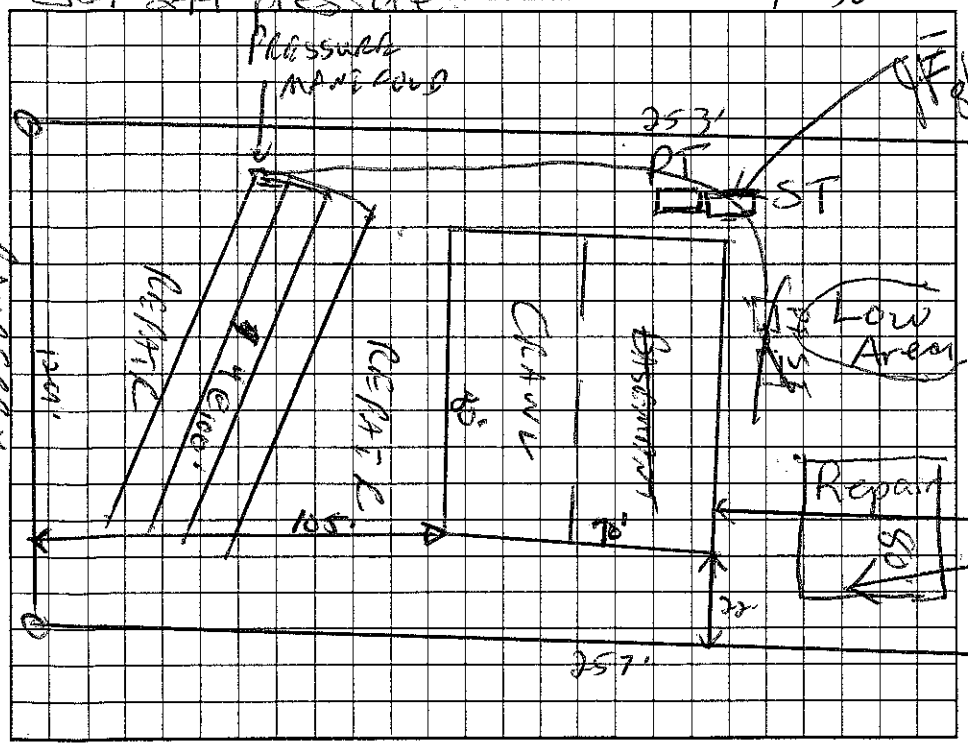

AS BUILT SKETCH

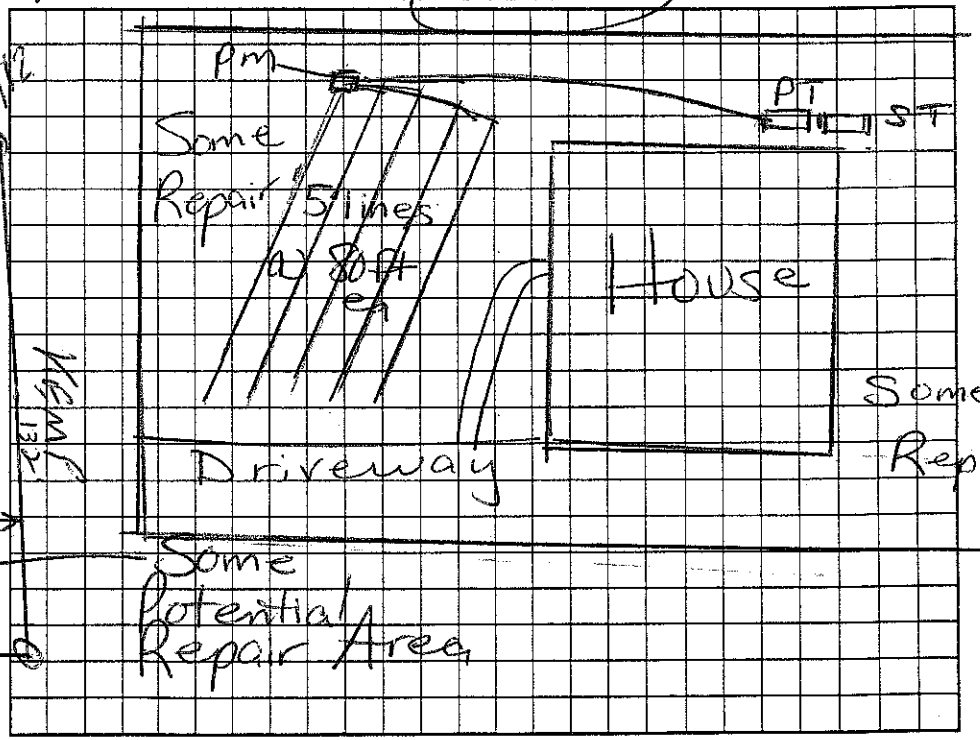

Permit can be suspended or revoked if any false information is supplied toward securing the permit/any unauthorized changes are made to the site/any unauthorized changes are made in the installation of the system. Improvement Permit with plat valid without expiration. Improvement Permit with site plan valid for sixty months. Authorization to Construct is valid for a period equal to that of Improvement Permit – not to exceed sixty months.

Signed: _____ date 7-12-04 Installed by: Stanley Septic

Improvement Permit by: _____ RS date 6/24/04 Operation Permit by: _____ RS date 9/10

Authorization to Construct by: _____ date 4-12-12 Existing System Inspection by: _____ date _____

HEALTH DEPT. COPY: WHITE OWNER COPY (FINAL): YELLOW OWNER COPY (INITIAL): PINK