# ELL COUNTY HEALTH DEPARTMENT

STATESVILLE 704-878-5305 MOORESVILLE 704-664-5281

## IMPROVEMENT PERMIT / AUTHORIZATION TO CONSTRUCT / OPERATION PERMIT / EXISTING SYSTEM INSPECTION

PERMIT# 073574 PIN# 4626267155 DATE 5/26/98

OWNER OR CONTRACTOR WILLIAM READLING PHONE: Business _____ Home 938-3104

ADDRESS 111 EASY ST CONCORD - NC 28027

LOCATION BRAWLEY SCHOOL RD - TR MCKENDREE - TL 1ST KEMP - 1.2 MILES ON LT.

SUBDIVISION CLAT BLOCK / SECTION 8 LOT 124 LOT AREA _____ SITE CLASS. PS DESIGN FLOW 360 L.T.A.R. _____

Septic Tank: EXISTING 1000 Gallons; STB _____ Date _____

Pump Tank: _____ Gallons; PT _____ Date _____

Pump Make: _____ Model _____ Serial No. _____

Nitrification Field: No Fields 1 Square Feet 756 Linear Feet 63

No Lines 4 Trench Width 12' Max Trench Bottom Depth — Gravel Depth 12"

☑ New System ☐ Repair System Type: I, II, III, IV, V, VI

System Description: GRAVITY CONVENTIONAL

Repair System Description: _____

Maintenance Agreement Required: ☐ Yes ☐ No

☑ House/Mod. Home No. Bedrooms 3

☐ Mobile Home No. Bathrooms 2

☐ Business No. Employees _____

☐ Other _____


☐ Slab ☐ Crawl Space ☐ Basement w/plumbing ☐ Basement wo/plumbing

Water Supply: ☑ Individual ☐ Public ☐ Community

Comments:/Conditions:

Comments:/Conditions:

**INITIAL SITE SKETCH**

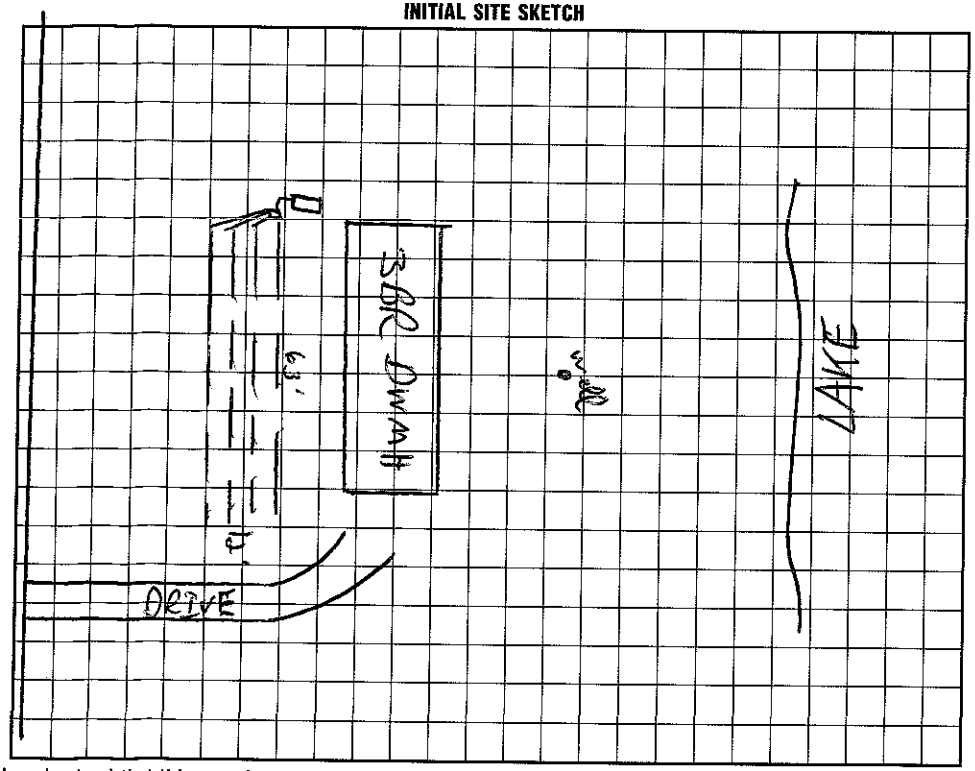


**AS BUILT SKETCH**

I understand that this permit can be suspended or revoked if any false information is supplied toward securing the permit/any unauthorized changes are made to the site/any unauthorized changes are made in the installation of the system. Improvement Permit with plat valid without expiration. Improvement Permit with site plan valid for sixty months. Authorization to Construct is valid for a period equal to that of Improvement Permit – not to exceed sixty months.

Signed: William B. Readling date 5-27-98 Installed by: _____

Improvement Permit by: _____ date _____ Operation Permit by: C. [illegible] date 5/26/98

Authorization to Construct by: _____ date _____ Existing System Inspection by: C. [illegible] date 5/26/98

HEALTH DEPT. COPY: WHITE INSPECTION COPY (FINAL): GREEN OWNER COPY (FINAL): YELLOW INSPECTION COPY (INITIAL): PINK OWNER COPY (INITIAL): GOLD