4:00

IREDELL COUNTY HEALTH DEPARTMENT

STATESVILLE 704-878-5305 375.00 Pd. 9 MOORESVILLE 704-664-5281

IMPROVEMENT PERMIT / AUTHORIZATION TO CONSTRUCT / OPERATION PERMIT / EXISTING SYSTEM INSPECTION

PERMIT# 118757 PIN# ~~4626-38-4001, 368~~ 4626-26-8769 DATE 7-29-05

OWNER OR CONTRACTOR Chris Tucker PHONE: Business 980-721-5434 Home 704-948-6836

ADDRESS 8533 Glade Ct.

LOCATION Brawley School Rd, TR McKendree, TL Kemp, TR Alder Spring, TL Bay Berry Creek Circle, on left

SUBDIVISION The Farms BLOCK / SECTION ______ LOT 368 LOT AREA .76 AC SITE CLASS. PS DESIGN FLOW 600gpd L.T.A.R. .3 gpd/ft²

Septic Tank: 1500 Gallons; STB 338 Date 2-15-06
Pump Tank: 1500 Gallons; PT 471 Date 2-2-06
Pump Make: ______ Model ______ Serial No. ______
Nitrification Field: No Fields 1 Square Feet ______ Linear Feet 333
No Lines 5 Trench Width 36" Max Trench Bottom Depth 36" Gravel Depth NA

☒ New System ☐ Repair System Type: I, II, III, (IV), V, VI
System Description: LP Panel
Repair System Description: LP Panel
Maintenance Agreement Required: ☒ Yes ☐ No

☒ House/Mod. Home No. Bedrooms 5
☐ Mobile Home No. Bathrooms ____
☐ Business No. Employees ____
☐ Other ______

☐ Slab ☒ Crawl Space ☐ Basement w/plumbing ☐ Basement wo/plumbing


Water Supply:
☐ Individual
☐ Public
☒ Community

Comments:/Conditions:
House to be restaked to 65' setback from Bayberry Crk. Circle property line

Comments:/Conditions: Checked tanks 4/3/06
Checked Drain Lines
Installed top 2 lines 4-5-06 JM
Checked bottom 3 lines 4-6-06

1" = 50'

INITIAL SITE SKETCH

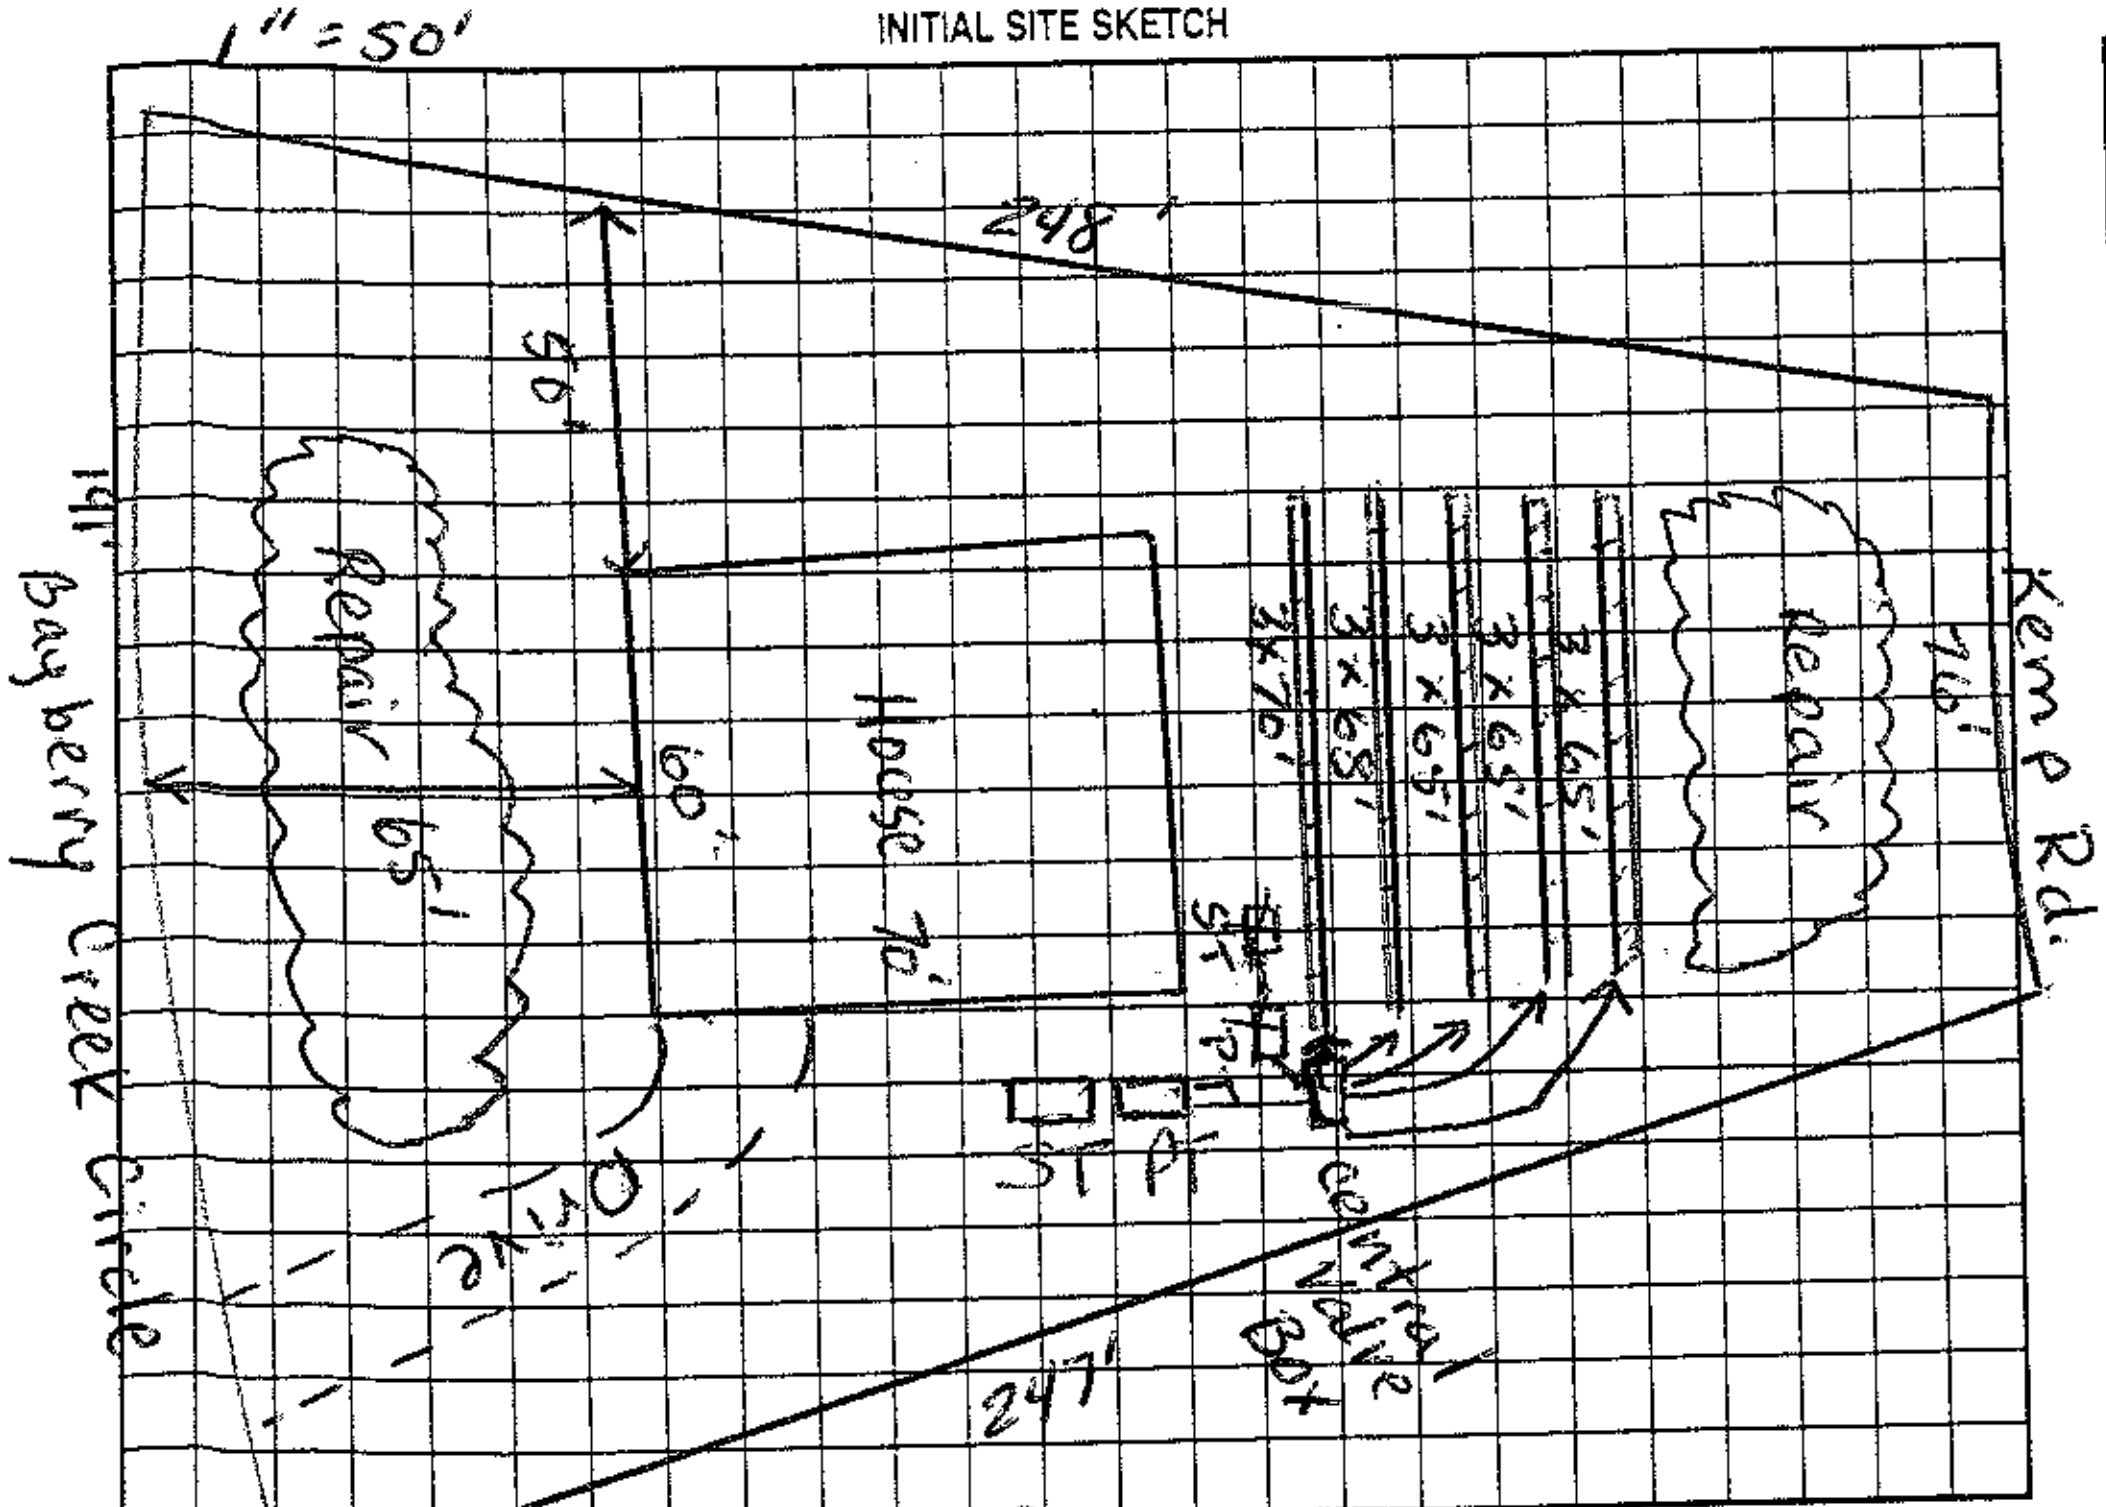

AS BUILT SKETCH

valve box ok 4-7-06 JM
pressure checked 4-10-06
Electrical checked 4-13-06

Permit can be suspended or revoked if any false information is supplied toward securing the permit/any unauthorized changes are made to the site/any unauthorized changes are made in the installation of the system. Improvement Permit with plat valid without expiration. Improvement Permit with site plan valid for sixty months. Authorization to Construct is valid for a period equal to that of Improvement Permit - not to exceed sixty months.

Signed: [signature] date 8-1-05 Installed by: Gerald Tucker

Improvement Permit by: Judy Melnille date 7-29-05 Operation Permit by: Judy Melnille date 4-13-06

Authorization to Construct by: Judy Melnille date 7-29-05 Existing System Inspection by: ______ date ______

HEALTH DEPT COPY: WHITE OWNER COPY (FINAL): YELLOW OWNER COPY (INITIAL): PINK