IREDELL COUNTY HEALTH DEPARTMENT

Statesville Office (704) 878-5305 Mooresville Office (704) 660-3625 PERMIT # 208332

IMPROVEMENT PERMIT / AUTHORIZATION TO CONSTRUCT / OPERATION PERMIT / EXISTING SYSTEM

PIN # 4626-26-9349

APPLICANT: DENISE OLIVER APPLICANT ADDRESS: 314 LAKEVIEW SHORES LOOP

SITE ADDRESS: 381 KEMP RD. PHONE: ALT. PHONE:

SITE DIRECTIONS: BSR, TR MCKENDREE, TL KEMP, ON L

SUBDIVISION: CLET SECTION: 8 LOT # 122 LOT AREA: .8 AC DESIGN FLOW: 480 L.T.A.R.: .25 (.1R)

Septic Tank EXISTING (gal) STB Date

Pump Tank (gal) PT Date

Pump Make Model Serial #

Nitrification Fields 1 # Lines 5C32' Linear Ft: 160'

Trench Width 24" Max. Trench Bottom Depth *30"* Gravel Depth —

☐ New System ☐ Repair ☒ Expansion System Type: I II (III) IV V VI

System Description: EXISTING BED + PANEL BLOCK

Repair System Description: DRIP

Maintenance Agreement Required: ☐ YES ☒ NO

☒ GRAVITY ☐ PRESSURE

☒ Residence ☐ Business ☐ Other ☐ Slab ☐ Basement w/plumbing

No. Bedrooms 4 No. Persons No. Employees ☒ Crawl Space

☐ Basement w/o plumbing

Water Supply: ☒ Private ☐ Public ☐ Community

Comments / Conditions: * EXISTING WELL MUST BE ABANDOND BEFORE AC IS ISSUED *

INITIAL SITE SKETCH

SEE PLAN FROM MICHAEL ATHANAS & ASSOCIATES

AS BUILT SKETCH

Permit can be suspended or revoked if any false information is supplied toward securing the permit / any unauthorized changes are made to the site / any unauthorized changes are made in the installation of the system. **CONTACT A LOCATOR SERVICE PRIOR TO ANY EXCAVATION**

☒ **IMPROVEMENT PERMIT** *with plat valid without expiration.* ☐ **IMPROVEMENT PERMIT** *with site plan valid for 60 mos.* ☒ **AUTHORIZATION TO CONSTRUCT** *valid for period equal to IMPROVEMENT PERMIT--not to exceed 60 mo.*

Owner / Applicant Signature: Date: 3/23/15

IMPROVEMENT PERMIT by: APPROVED FEB 20 2015 Date:


AUTHORIZATION TO CONSTRUCT by: Date: 5-1-15

Installed by: LARRY HENKLE

OPERATION PERMIT by: Date: 10-19-15

Existing System Inspected by: Date:

Health Dept. Copy - WHITE Applicant (Final Approval) - YELLOW Applicant (Conditional Approval) - PINK

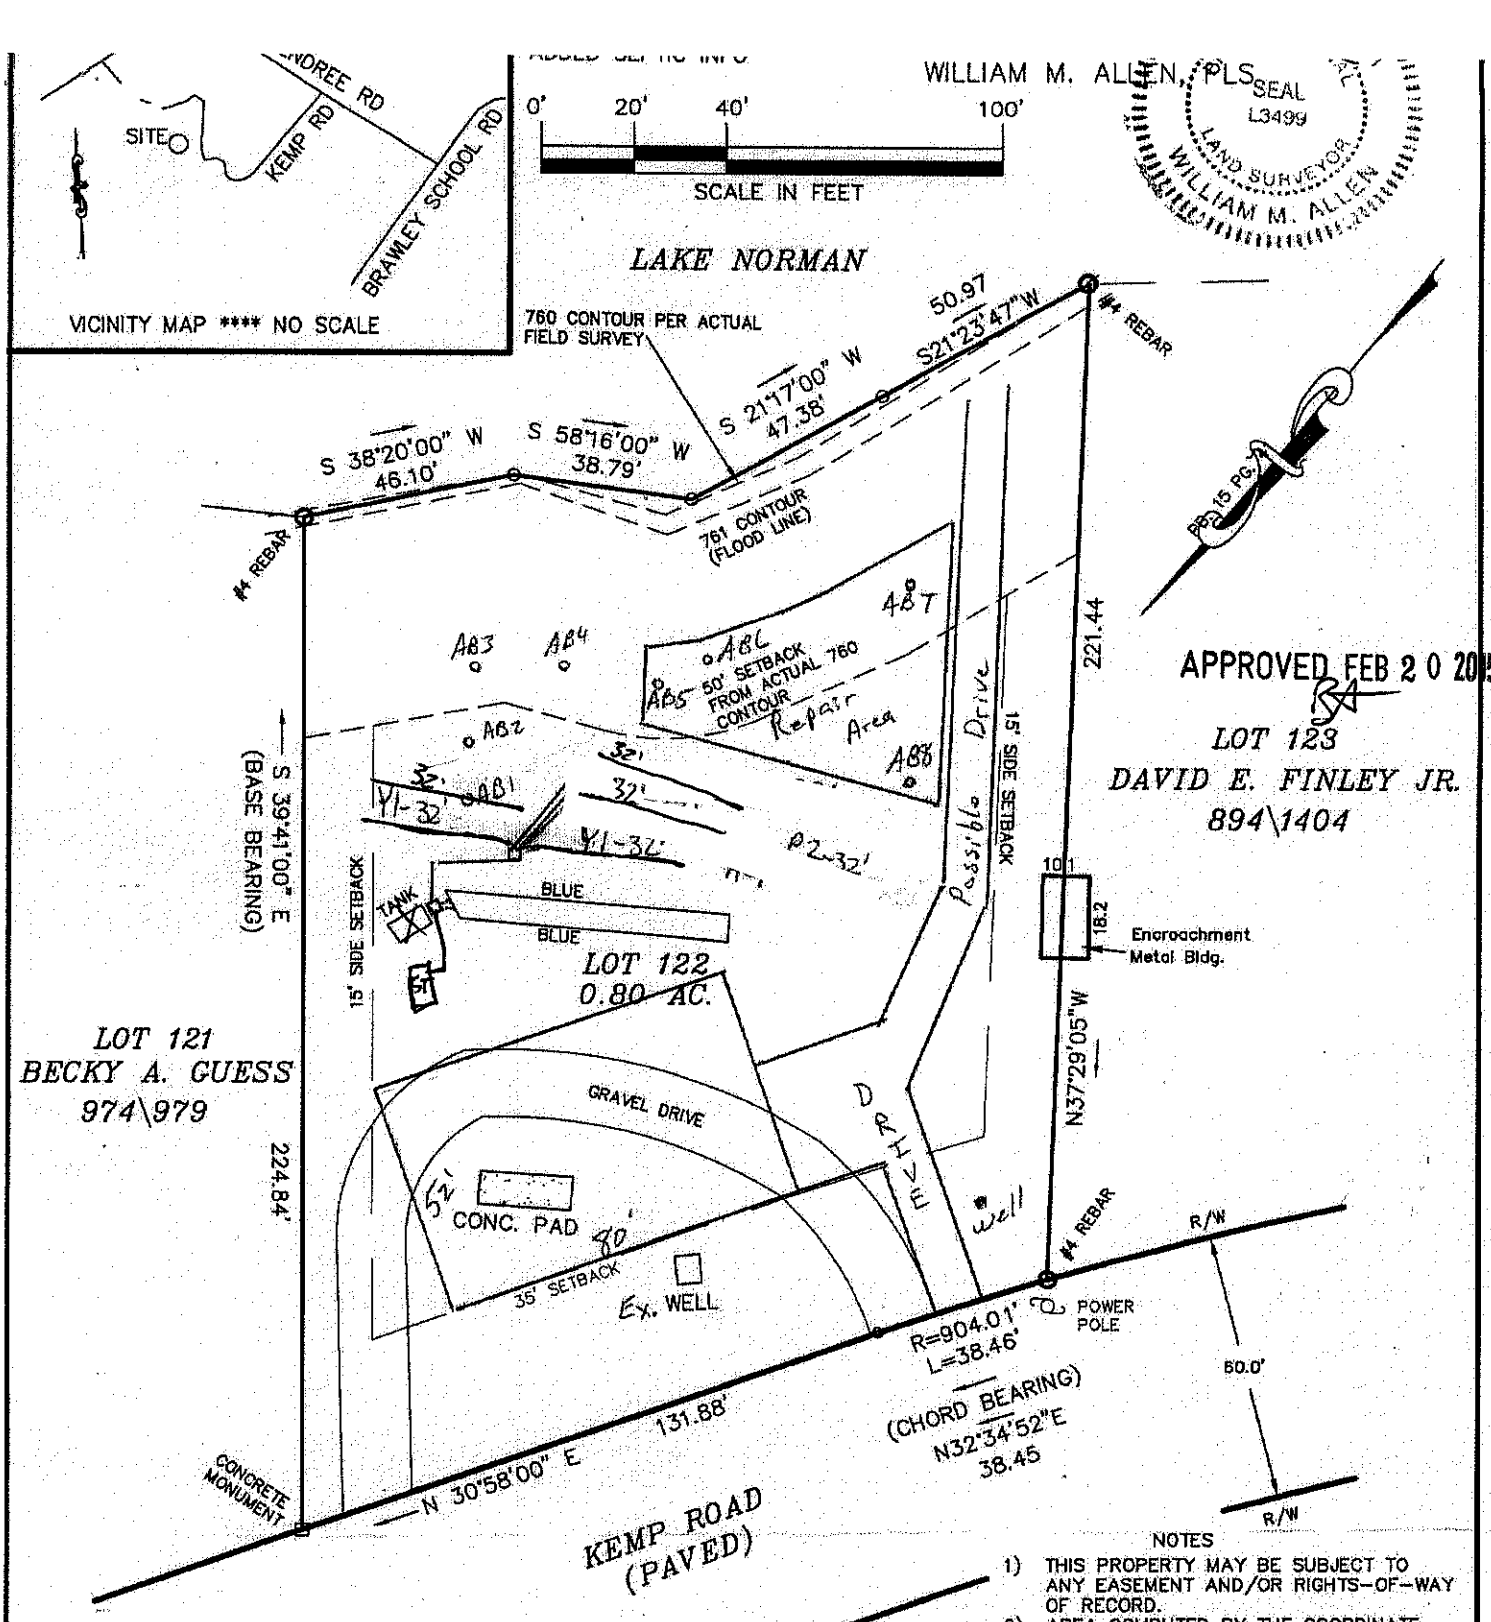

LEGEND

- P.P. = POWER POLE
- = POWER TRANS.
- E.I.P. = EXISTING IRON FOUND
- I.P.S. = #4 REBAR SET
- R/W = RIGHT-OF-WAY
- CP = COMPUTED POINT

NOTES

1) THIS PROPERTY MAY BE SUBJECT TO ANY EASEMENT AND/OR RIGHTS-OF-WAY OF RECORD.
2) AREA COMPUTED BY THE COORDINATE METHOD.
3) EXISTING 760' & 761' CONTOUR ELEVATION BASED ON LAKE NORMAN LAKE LEVEL AT COWAN'S FORD DAM (READING ON 1\20\15) ELEVATION: 756.48
4) UNDERGROUND POWER
5) NO GRID MONUMENT FOUND WITHIN 2000 FEET.

BOUNDARY SURVEY

OF

381 KEMP RD.

LOT 122 CRESCENT LAND AND TIMBER CORP., SECT. 8

SCALE 1" = 40'

DAVIDSON TWSP., IREDELL CO., N.C.

ACQUIRED BY: KEVIN & DENISE OLIVER

FIELD BOOK: 500-D
FILE: CLT 122 SB
DC FILE:
TAX MAP NO.