# IREDELL COUNTY HEALTH DEPARTMENT

Authorization To Construct (2530)

STATESVILLE 704-878-5305 MOORESVILLE 704-664-5281

## IMPROVEMENT PERMIT / ~~CERTIFICATE OF COMPLETION~~ / OPERATION PERMIT / EXISTING SYSTEM INSPECTION

PROPERTY DESCRIPTION NO. 067192 DATE 6/24/97 TAX MAP NO. 4626270260 Watershed: [X] Yes [ ] No

OWNER OR CONTRACTOR Reid Holland PHONE: Business 663-2223 Home

ADDRESS 497 Kemp Rd. Mooresville, NC. 28115

LOCATION Brawley Sch TR McKendree Rd. TL Kemp ~ 1.5 mile on (L)

SUBDIVISION C L + T BLOCK / SECTION 3 LOT 145 LOT AREA .7 AC SITE CLASS. PS DESIGN FLOW 360 L.T.A.R. .3

Septic Tank: 1000 Gallons; STB 825 Date 11/14/97

Pump Tank: Gallons; PT Date

Pump Make: Model Serial No.

Nitrification Field: No Fields 1 Square Feet 900 Linear Feet 300+

No Lines 3 Trench Width 36" Max Trench Bottom Depth 36" Gravel Depth SAND.

[X] New System [ ] Repair System Type: I, II, (III), IV, V, VI

System Description: BRAV - CH PLASTIC

Repair System Description:

Maintenance Agreement Required: [ ] Yes [ ] No

[X] House/Mod. Home No. Bedrooms 3

[ ] Mobile Home No. Bathrooms 2

[ ] Business No. Employees


[ ] Other

[ ] Slab [X] Crawl Space [ ] Basement w/plumbing [ ] Basement wo/plumbing

Water Supply: [X] Individual [ ] Community [ ] Public


Comments: +CH PLASTIC - 25% REDUCTION

INITIAL SITE SKETCH

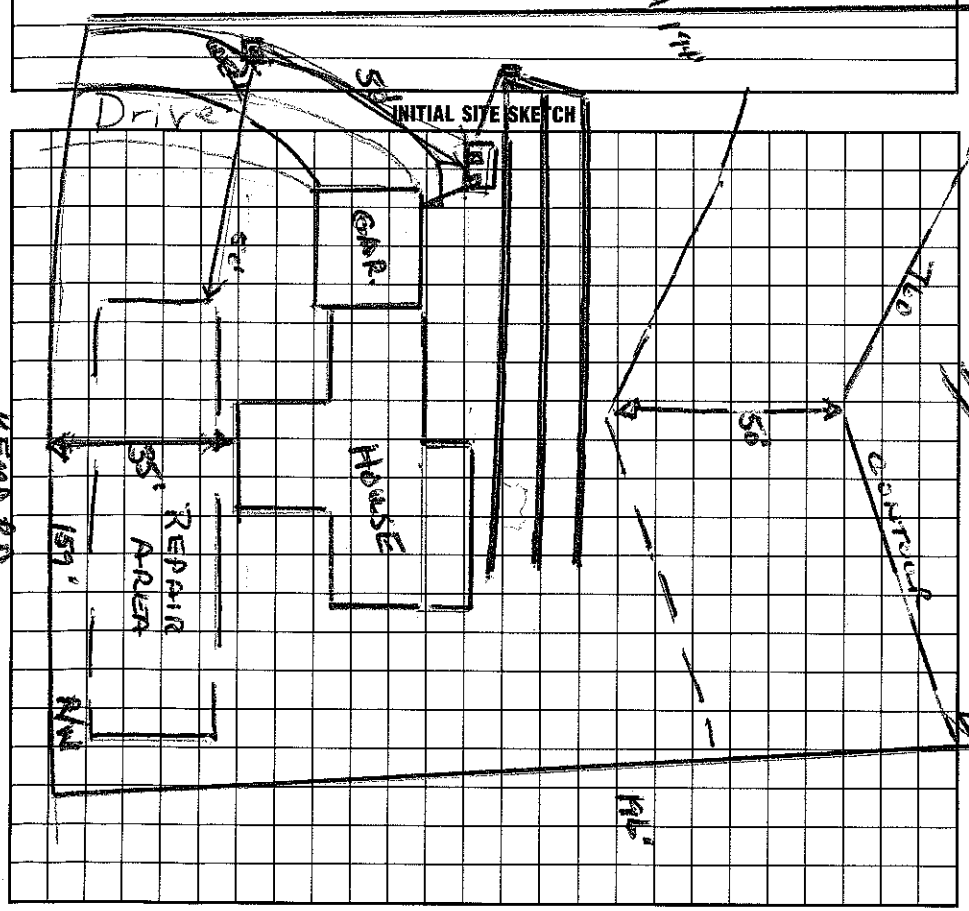


Comments:

AS BUILT SKETCH

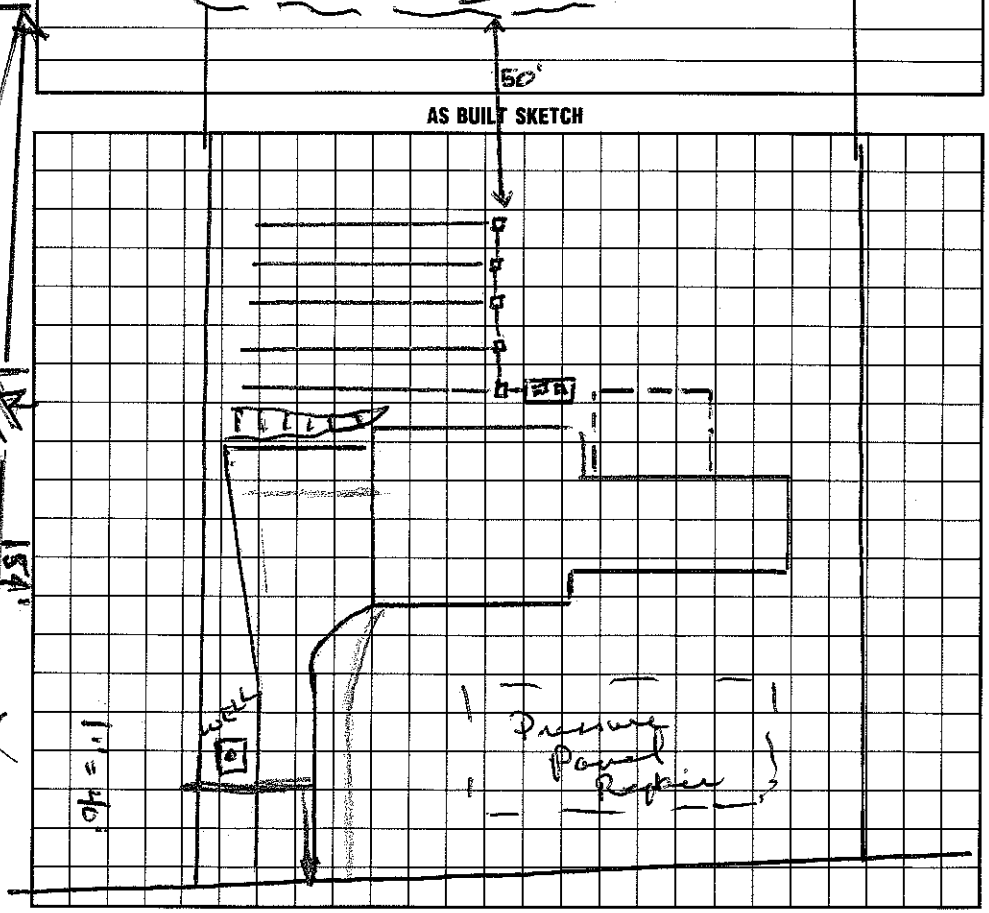


I understand that this permit can be suspended or revoked if any false information is supplied toward securing the permit/any unauthorized changes are made to the site/any unauthorized changes are made in the installation of the system. Improvement Permit is valid for 60 months from date of issuance.

Signed: *[signature]

Improvement Permit by: Wesley Sparks R.S. date 6/24/97

~~Authorization To Construct~~ by: Wesley Sparks R.S. date 6/24/97

Installed by: Barry Thompson

Certificate of Completion by: Wesley Sparks R.S. date 2/2/98

Operation Permit by: Wesley Sparks R.S. date 2/2/98

HEALTH DEPT. COPY: WHITE INSPECTION COPY (FINAL): GREEN OWNER COPY (FINAL): YELLOW INSPECTION COPY (INITIAL): PINK OWNER COPY (INITIAL): GOLD