4626273032

IREDELL COUNTY HEALTH DEPARTMENT

STATESVILLE 704-878-5305 MOORESVILLE 704-664-5281

IMPROVEMENT PERMIT / AUTHORIZATION TO CONSTRUCT / OPERATION PERMIT / EXISTING SYSTEM INSPECTION

PERMIT# 118714 PIN# ~~4626384001.352~~ DATE 6-18-07

OWNER OR APPLICANT J. Shaun Ogden PHONE: Business 704 309-6810 Home

ADDRESS P.O. Box 1281 Davidson, NC 28136

LOCATION Brawley School Rd TR McKendree TL Kemp TR Alder Springs TL Bayberry on Rt near end

SUBDIVISION The Farms BLOCK / SECTION III LOT 352 LOT AREA 1.06 Acre SITE CLASS. PS DESIGN FLOW 480gpd L.T.A.R. .3

Septic Tank ~~1500~~ Gallons; STB 338 Date 5-14-07

Pump Tank: Gallons; PT Date

Pump Make: Model Serial No.

Nitrification Field: No Fields 1 Square Feet 1200 Linear Feet 400

No Lines 4@100' Trench Width 36" Max Trench Bottom Depth 36"

☒ New System ☐ Repair ☐ Expansion System Type: I II ☒ III IV V VI

System Description: Gravity - 25% Reduction

Repair System Description: Pump/Grav 25%-50% Reduction

Maintenance Agreement Required: ☐ Yes ☒ No

Gravel Depth N/A ☒ Gravity ☐ Pressure

☒ House/Mod. Home ☐ Mobile Home ☐ Business ☐ Other

No. Bedrooms 4 No. Persons No. Employees

☐ Slab ☒ Crawl Space ☐ Basement w/plumbing ☐ Basement wo/plumbing


Water Supply: ☐ Individual ☐ Public ☒ Community

Comments:/Conditions:


Scale 1:50

Comments:/Conditions: ☒ Must keep Swimming pool at least 15ft from Septic System.

INITIAL SITE SKETCH

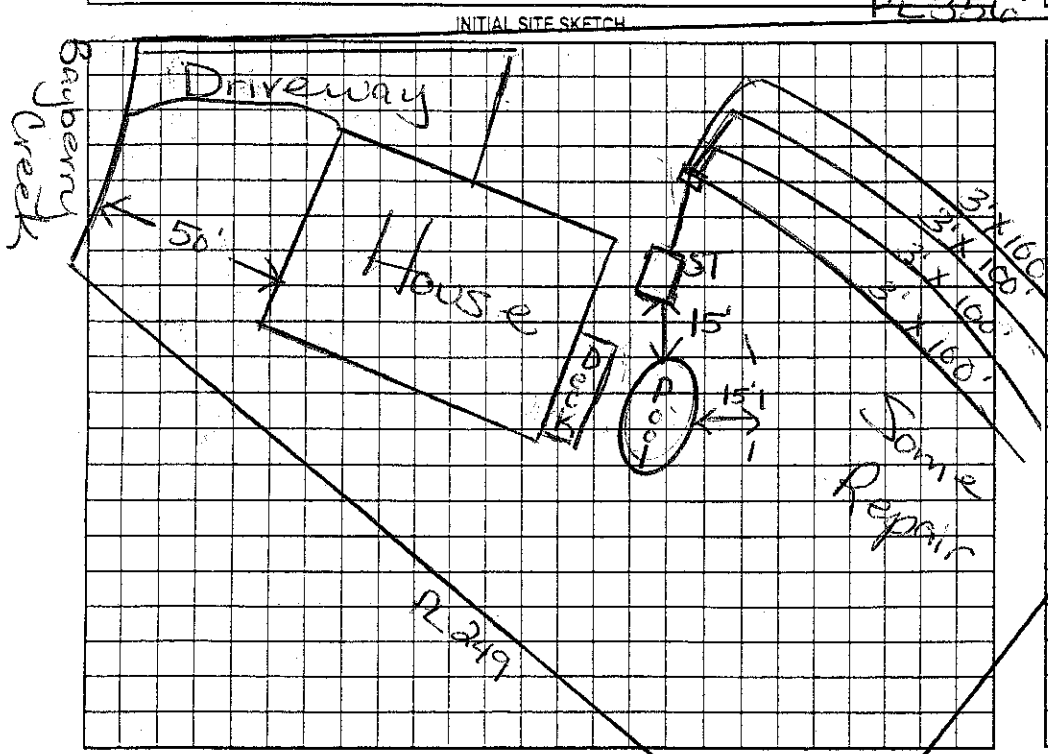

AS BUILT SKETCH

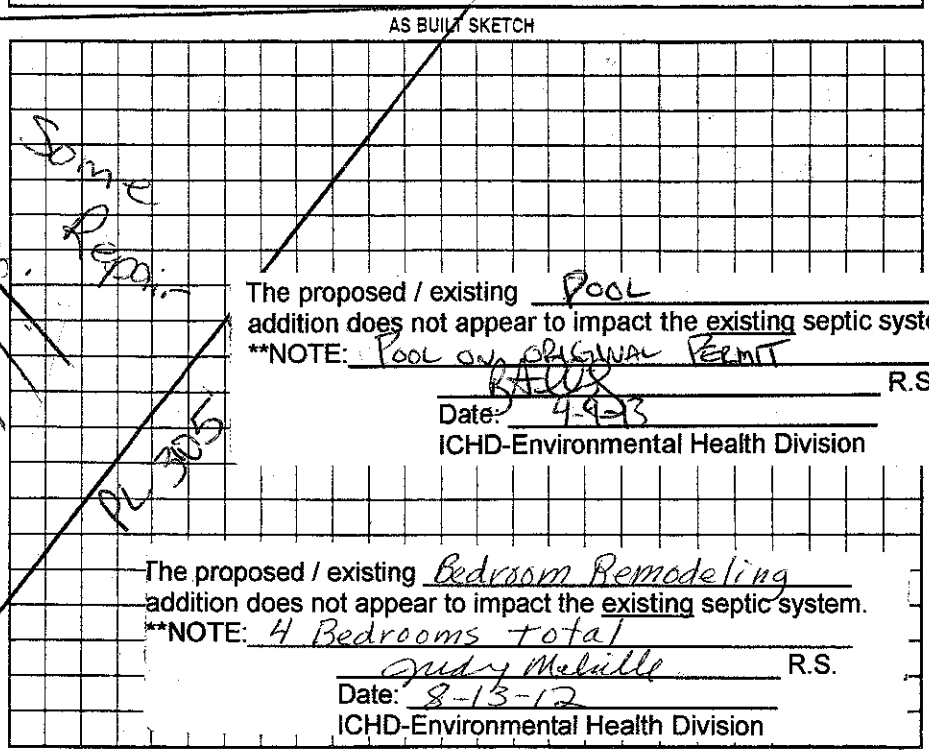

The proposed / existing Pool addition does not appear to impact the existing septic system.

**NOTE: Pool on ORIGINAL PERMIT

BAW R.S.

Date: 4-9-13

ICHD-Environmental Health Division

The proposed / existing Bedroom Remodeling addition does not appear to impact the existing septic system.

**NOTE: 4 Bedrooms total

Judy Melville R.S.

Date: 8-13-12

ICHD-Environmental Health Division

Permit can be suspended or revoked if any false information is supplied toward securing the permit/any unauthorized changes are made to the site/any unauthorized changes are made in the installation of the system. Improvement Permit with plat valid without expiration ☐ Improvement Permit with site plan valid for sixty months ☐ Authorization to Construct is valid for a period equal to that of Improvement Permit – not to exceed sixty months.

Signed: J. Shaun Ogden date 6-19-07 Installed by: Richard Abernethy

Improvement Permit by: Maintained by Olson RS date 6/18/07 Operation Permit by: John E Ayer date 6-22-07

Authorization to Construct by: Maintained by Olson RS date 6/18/07 Existing System Inspection by: date

HEALTH DEPT. COPY: WHITE OWNER COPY (FINAL): YELLOW OWNER COPY (INITIAL): PINK