IREDELL COUNTY HEALTH DEPARTMENT

STATESVILLE 704-878-5305 MOORESVILLE 704-664-5281

IMPROVEMENT PERMIT / AUTHORIZATION TO CONSTRUCT / OPERATION PERMIT / EXISTING SYSTEM INSPECTION

PERMIT# 118710 PIN# 4626 384 001 . 346 4626 274138 DATE 4/5/05

OWNER OR CONTRACTOR Sean Gallagher PHONE: Business 704 799 9082 Home 704 799 3323

ADDRESS 146 Vineyard Dr. Mooresville NC 28117

LOCATION BSR, TR McKendree, TL Kemp, TR Alder springs, TL Bayberry, TR Anderson Farm, at End

SUBDIVISION Farms BLOCK / SECTION 3 LOT 346 LOT AREA 1.576 ac SITE CLASS PS DESIGN FLOW 600 L.T.A.R. 0.3

Septic Tank: 1500 Gallons: STB 338 Date 7/9/05

Pump Tank: Gallons: PT Date

Pump Make: Model Serial No.

Nitrification Field: No Fields 1 Square Feet 1500 Linear Feet 500

No Lines 4@125' Trench Width 36" Max Trench Bottom Depth 36" Gravel Depth —

☒ New System ☐ Repair System Type: I, II, III, IV, V, VI

System Description: Gravity 25% Reduct.

Repair System Description: Pump Panel Block

Maintenance Agreement Required: ☐ Yes ☒ No

☒ House/Mod. Home No. Bedrooms 5

☐ Mobile Home No. Bathrooms

☐ Business No. Employees

☐ Other

☐ Slab ☒ Crawl Space ☐ Basement w/plumbing ☐ Basement wo/plumbing


Water Supply: ☐ Individual ☐ Public ☒ Community

Comments:/Conditions:


1"=50'

Comments:/Conditions:

INITIAL SITE SKETCH

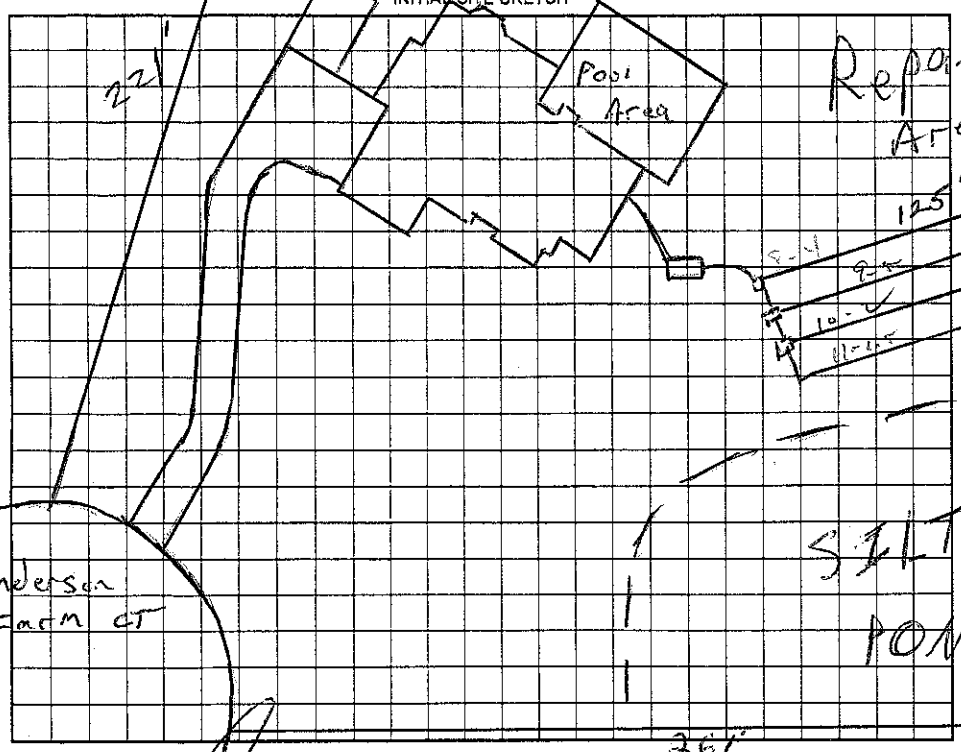

AS-BUILT SKETCH

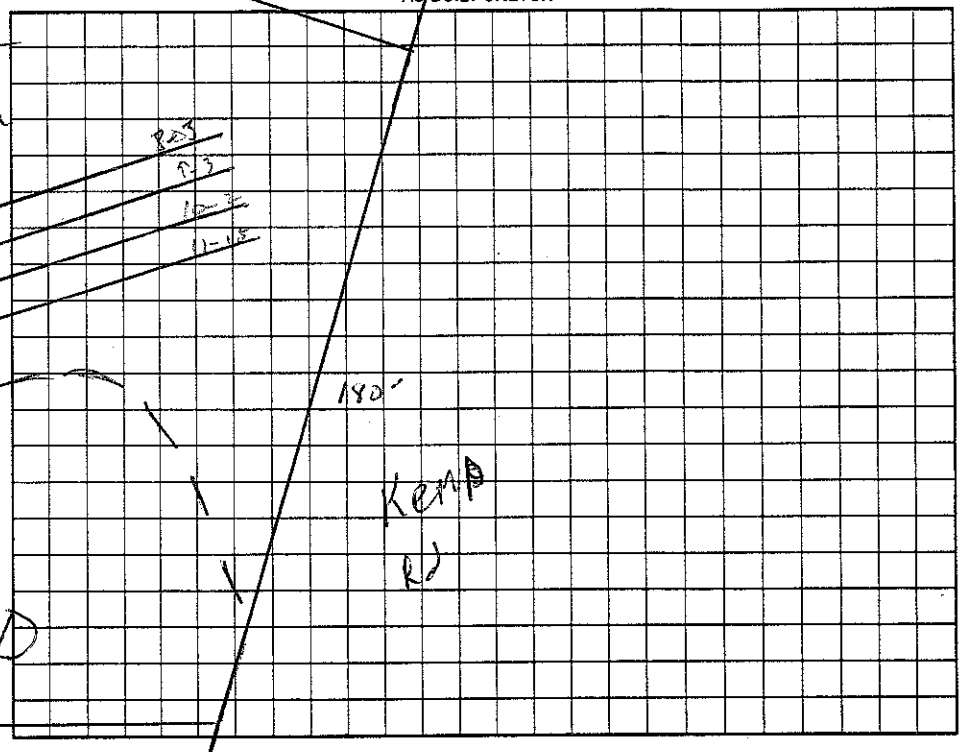

Permit can be suspended or revoked if any false information is supplied toward securing the permit/any unauthorized changes are made to the site/any unauthorized changes are made in the installation of the system. Improvement Permit with plat valid without expiration. Improvement Permit with site plan valid for sixty months. Authorization to Construct is valid for a period equal to that of Improvement Permit – not to exceed sixty months.

Signed: date 4-5-05 Installed by: Richard Abernathy

Improvement Permit by: RS date 4/5/05 Operation Permit by: Wesley Sparks R.S. date 8/9/05

Authorization to Construct by: RS date 4/5/05 Existing System Inspection by: date

HEALTH DEPT. COPY: WHITE OWNER COPY (FINAL): YELLOW OWNER COPY (INITIAL): PINK