4626275354

IREDELL COUNTY HEALTH DEPARTMENT

STATESVILLE 704-878-5305 MOORESVILLE 704-664-5281

IMPROVEMENT PERMIT / AUTHORIZATION TO CONSTRUCT / OPERATION PERMIT / EXISTING SYSTEM INSPECTION

PERMIT# 118709 PIN# 4626 35 4001.345 DATE 6/21/04

OWNER OR CONTRACTOR THE FARMS LLC / David Dibble Custom Homes PHONE: Business 660-1185 Home

ADDRESS 2214 BRAWLEY SCHOOL - MOORESVILLE NC 28115

LOCATION BRAWLEY SCHOOL - JR MCKENDREE - TL KEMP - TR ALDER SPRINGS - TL BAYBERRY - TR ANDERSON FARM - AT END

SUBDIVISION TITE FARMS BLOCK / SECTION 3 LOT 345 LOT AREA .97AC SITE CLASS. PS DESIGN FLOW 480GPD L.T.A.R. .25GPD/FT²

Septic Tank: 1000 Gallons; STB Date 8/5/04
Pump Tank: Gallons; PT Date
Pump Make: Model Serial No.
Nitrification Field: No Fields 1 Square Feet 1500 Linear Feet 500
No Lines 5 @ 100' Trench Width 36" Max Trench Bottom Depth 36"

☑ New System ☐ Repair System Type: I, II, III, IV, V, VI
System Description: GRAVITY 25% REDUCTION
Repair System Description: LP PANEL
Maintenance Agreement Required: ☐ Yes ☑ No

☐ House/Mod. Home No. Bedrooms 4
☐ Mobile Home No. Bathrooms 4
☐ Business No. Employees
☐ Other
☐ Slab ☑ Crawl Space ☐ Basement w/plumbing ☐ Basement wo/plumbing


Water Supply: ☐ Individual ☐ Public ☑ Community

Comments:/Conditions:

Comments:/Conditions:
IQW4 w/ Installed

1"=50'

INITIAL SITE SKETCH

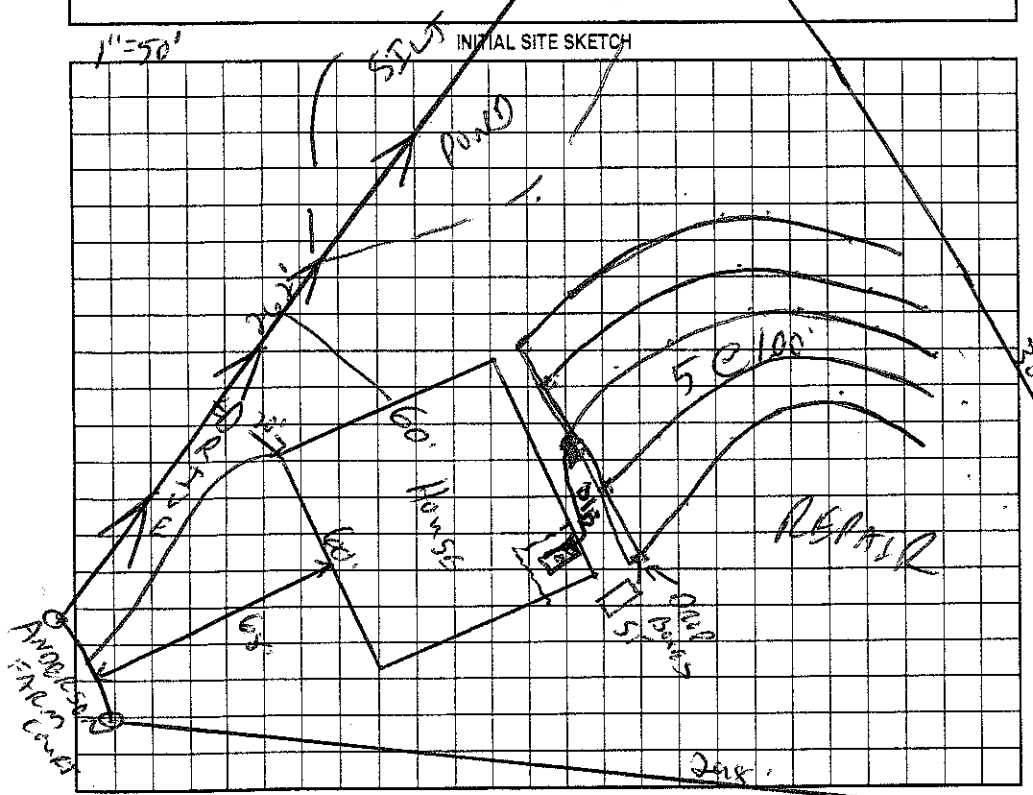

AS BUILT SKETCH

Permit can be suspended or revoked if any false information is supplied toward securing the permit/any unauthorized changes are made to the site/any unauthorized changes are made in the installation of the system. Improvement Permit with plat valid without expiration. Improvement Permit with site plan valid for sixty months. Authorization to Construct is valid for a period equal to that of Improvement Permit – not to exceed sixty months.

Signed: date 7-12-04

Improvement Permit by: date 6/21/04

Authorization to Construct by: RS date 5/20/05

Installed by: Orbison & Sons

Operation Permit by: Wesley Sparks RS date 9/20/05

Existing System Inspection by: date

HEALTH DEPT. COPY: WHITE OWNER COPY (FINAL): YELLOW OWNER COPY (INITIAL): PINK