10:00

IREDELL COUNTY HEALTH DEPARTMENT

STATESVILLE 704-878-5305 MOORESVILLE 704-664-5281

IMPROVEMENT PERMIT / AUTHORIZATION TO CONSTRUCT / OPERATION PERMIT / EXISTING SYSTEM INSPECTION

PERMIT# 118708 PIN# ~~4626 38 4001. 344~~ 4626276484.000 DATE 6/21/04

OWNER OR CONTRACTOR THE FARMS LLC / Craig Carter PHONE: Business 660-1185 Home 336 345-3055

ADDRESS 2214 BRAWLEY SCHOOL - MOORESVILLE NC 28115 Craig Carter

LOCATION BRAWLEY SCHOOL - TR MCKENDREE - TL KEMP - TR ALGER SPRINGS - TL BAYBERRY - TR ANDERSON FARM - AT END

SUBDIVISION THE FARMS BLOCK / SECTION III LOT 344 LOT AREA 1.29AC SITE CLASS. PS DESIGN FLOW 480GPD L.T.A.R. ~~.35~~ .40 GPD/SFD

Septic Tank: ~~1000~~ 1500 Gallons; STB 338 Date 7/30/05

Pump Tank: 1000 Gallons; PT 283 Date 9/28/05

Pump Make: MYERS Model ME .3F Serial No. 04/05

Nitrification Field: No Fields 1 Square Feet 1440 Linear Feet 480 30

No Lines 4@120' Trench Width 36" Max Trench Bottom Depth 36" Gravel Depth N/A

☑ New System ☐ Repair System Type: I, II, III, IV, V, VI

System Description: PUMP 25% REDUCTION

Repair System Description: SAME

Maintenance Agreement Required: ☐ Yes ☑ No

☑ House/Mod. Home No. Bedrooms 4

☐ Mobile Home No. Bathrooms 4

☐ Business No. Employees ____

☐ Other ____

☐ Slab ☑ Crawl Space ☐ Basement w/plumbing ☐ Basement wo/plumbing

Water Supply: ☐ Individual ☐ Public ☑ Community

Comments/Conditions:

Comments/Conditions:

The proposed / existing DECK addition does not appear to impact the existing septic system.


**NOTE: MUST BE 5' FROM SEPTIC TANK


R.S.

Date: APPROVED JUN 26 2014

ICHD-Environmental Health Division

1" = 50' INITIAL SITE SKETCH

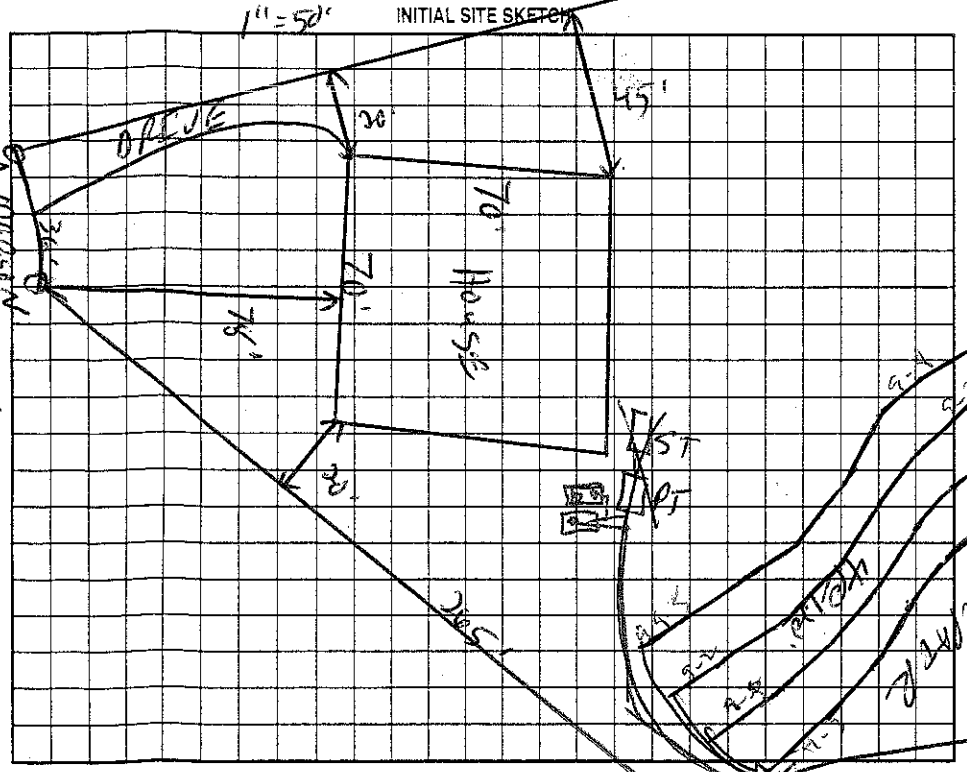

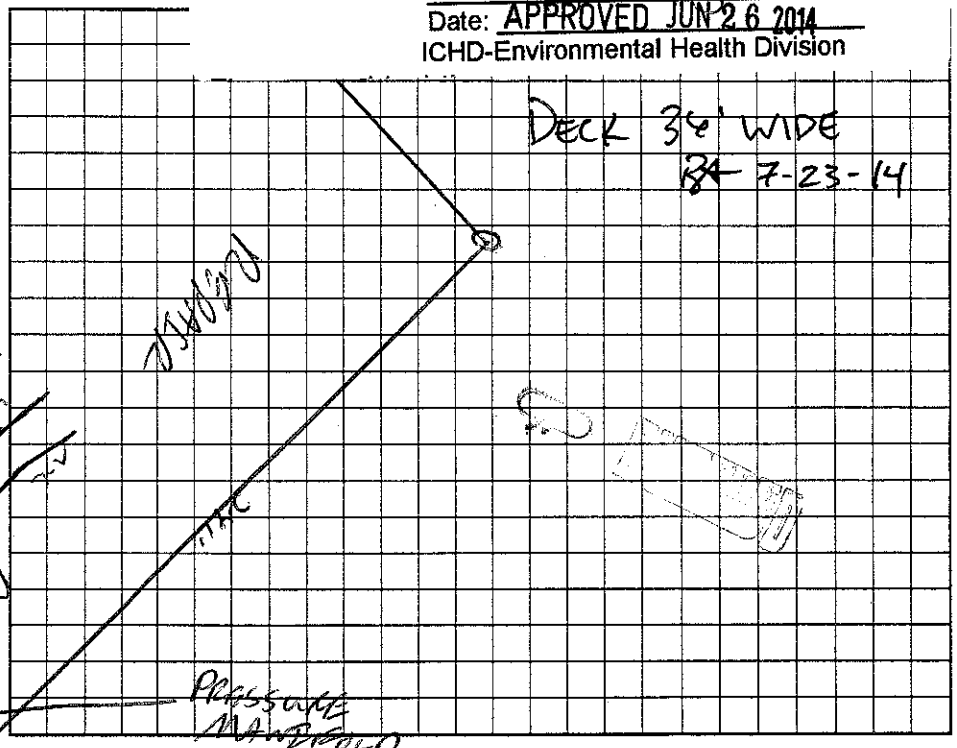

Permit can be suspended or revoked if any false information is supplied toward securing the permit/any unauthorized changes are made to the site/any unauthorized changes are made in the installation of the system. Improvement Permit with plat valid without expiration. Improvement Permit with site plan valid for sixty months. Authorization to Construct is valid for a period equal to that of Improvement Permit – not to exceed sixty months.

Signed: ____ date 7-12-04 Installed by: Howard Enterprises

Improvement Permit by: C. [illegible] R.S. date 6/21/04 Operation Permit by: Wesley Sparks R.S. date 1/9/06

Authorization to Construct by: [illegible] R.S. date 3/17/05 Existing System Inspection by: ____ date ____

HEALTH DEPT. COPY: WHITE OWNER COPY (FINAL): YELLOW OWNER COPY (INITIAL): PINK