10:00

IREDELL COUNTY HEALTH DEPARTMENT

STATESVILLE 704-878-5305 MOORESVILLE 704-664-5281

IMPROVEMENT PERMIT / AUTHORIZATION TO CONSTRUCT / OPERATION PERMIT / EXISTING SYSTEM INSPECTION

PERMIT# 118708 PIN# ~~4626384001.344~~ 4626276484.000 DATE 6/21/04

OWNER OR CONTRACTOR THE FARMS LLC / Craig Carter PHONE: Business 660-1185 Home 336 345-3055 Craig Carter

ADDRESS 2214 BRAWLEY School - MOORESVILLE NC 28115

LOCATION BRAWLEY SCHOOL - TR McKENDREE - TL KEMP - TR ALDER SPRINGS - TL BAYBERRY - TR ANDERSON FARM - AT END

SUBDIVISION THE FARMS BLOCK / SECTION III LOT 344 LOT AREA 1.29AC SITE CLASS. PS DESIGN FLOW ~~480GPD~~ 360 GPD L.T.A.R. ~~.35~~ .25 GPD/SF

Septic Tank: ~~1000~~ 1500 Gallons; STB 338 Date 7/30/05

Pump Tank: 1000 Gallons; PT 283 Date 9/28/05

Pump Make: MYERS Model ME 3F Serial No. 04105

Nitrification Field: No Fields 1 Square Feet 1440 Linear Feet ~~480~~ 360

No Lines 4@120' Trench Width 36" Max Trench Bottom Depth 36" Gravel Depth N/A

☑ New System ☐ Repair System Type: I, II, III, IV, V, VI

System Description: PUMP 25% REDUCTION

Repair System Description: SAME

Maintenance Agreement Required: ☐ Yes ☑ No

☑ House/Mod. Home No. Bedrooms 4

☐ Mobile Home No. Bathrooms 4

☐ Business No. Employees

☐ Other


☐ Slab ☑ Crawl Space ☐ Basement w/plumbing ☐ Basement wo/plumbing

Water Supply: ☐ Individual ☐ Public ☑ Community


Comments:/Conditions:

Comments:/Conditions:

1" = 50' INITIAL SITE SKETCH

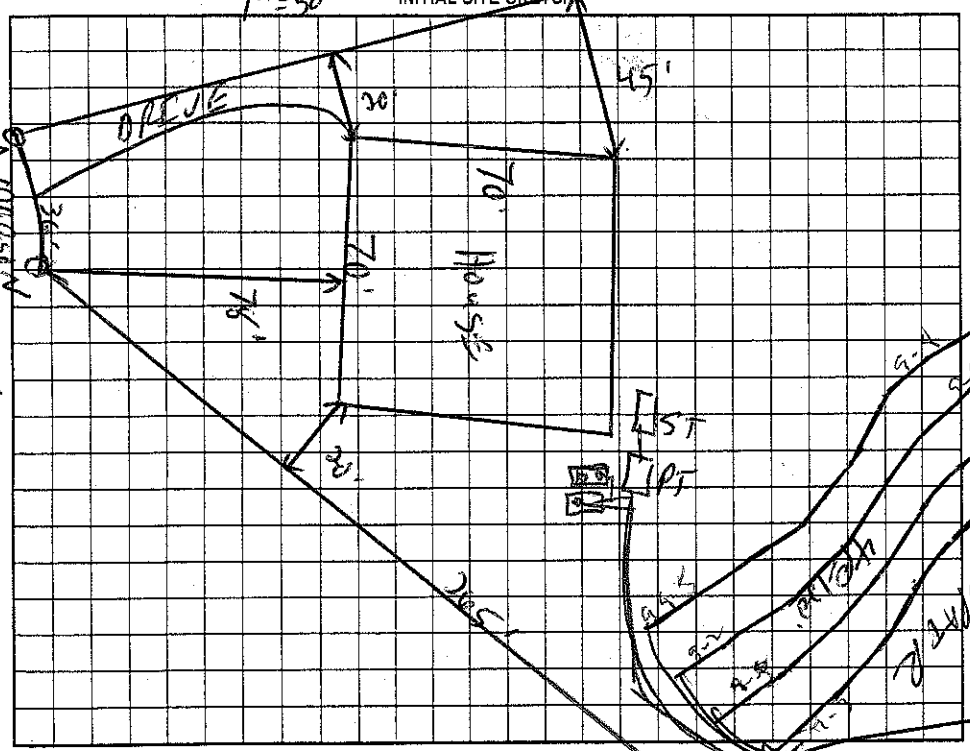

AS BUILT SKETCH

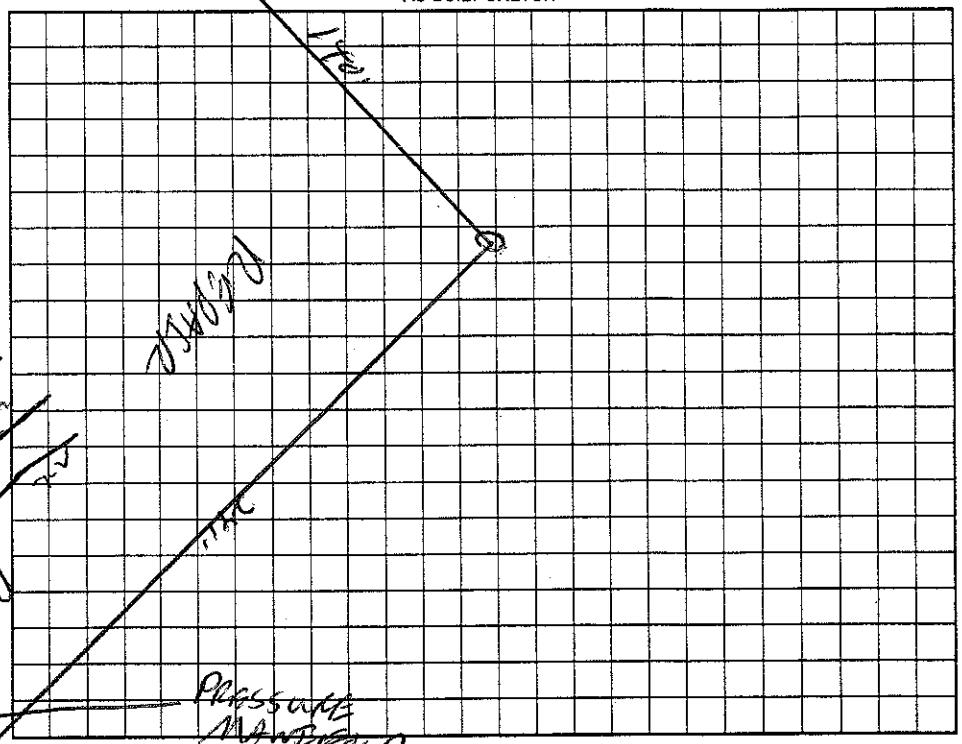

Permit can be suspended or revoked if any false information is supplied toward securing the permit/any unauthorized changes are made to the site/any unauthorized changes are made in the installation of the system. Improvement Permit with plat valid without expiration. Improvement Permit with site plan valid for sixty months. Authorization to Construct is valid for a period equal to that of Improvement Permit – not to exceed sixty months.

Signed: [signature] date 7-12-04 Installed by: Howard Enterprises

Improvement Permit by: C. [signature] RS date 6/21/04 Operation Permit by: Wesley Sparks RS date 1/9/06

Authorization to Construct by: [signature] RS date 3/17/05 Existing System Inspection by: _____ date _____

HEALTH DEPT. COPY: WHITE OWNER COPY (FINAL): YELLOW OWNER COPY (INITIAL): PINK